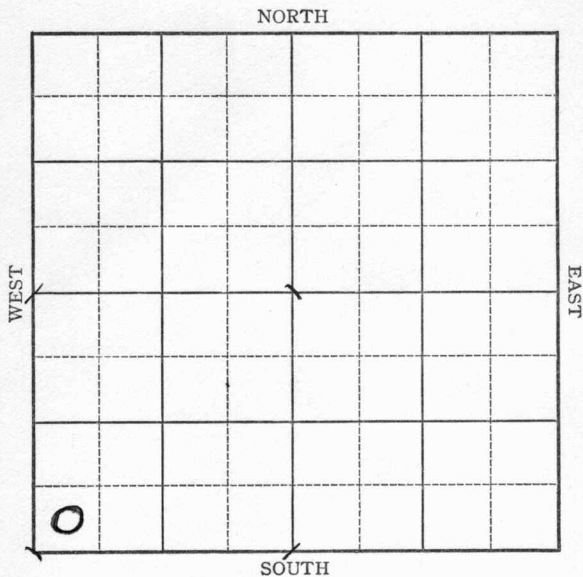


Russell

Section 36 Township 15 Range 14-WWell No. 1 - DumblerCompany Shell

1937

10/20 12" @ 656'.

7" @ 3325'.

Sil. 3323'.

T.D. 3347'.

3000 acid.

Pump 236 bbls. 4 hrs & 128.3
bbls. 4 hours.

Potential 772 bbls.

COMPLETED

KANSAS

Russell

Map No. _____ Sec. 36 Twp. 15 R. 14WWell No. 1-DumblerShell Company

Contractor _____

FIRST REPORT

SECTION PLAT

 Ft. from N. Line330 Ft. from S. Line Ft. from E. Line330 Ft. from W. Line

Location _____

Rig up _____

Drilling and Remarks:

BRR

RECORD

Cased _____ in., _____ ft.

Sand _____

Gas _____

Oil _____

Total Depth _____

PRODUCTION

1st 24 hrs. Nat. _____

1st 24 hrs. after shot _____

Gas _____ Cu. Ft.

Dry Hole _____

Abandoned _____

Date

SEP 1 1937 19H. D. Hatfield Scout

Russell KANSAS

Map No. _____ Sec. 36 Twp. 15 R. 14WWell No. 1 DumblerShell

Company _____

Contractor _____

COMPLETED

SW/C

_____ Ft. from N. Line

330 Ft. from S. Line

_____ Ft. from E. Line

330 Ft. from W. Line

SECTION PLAT

0			

Location _____

Rig up _____

Drilling and Remarks:

3000 AcidP-236/4128.3/4POT-77212" - 656
RECORDCased 7 in., 3325 ft.Sand 511 3323

Gas _____

Oil _____

Total Depth 3347

PRODUCTION

1st 24 hrs. Nat. _____

1st 24 hrs. after shot _____

Gas _____ Cu. Ft.

Dry Hole _____

Abandoned _____

Date

OCT 20 1937

19

H. D. Hatfield Scout