

Section 3 Township 29 Range 6 EWell No. # 3 MeedCompany Dunn & Strait

NORTH

						0	

WEST

EAST

SOUTH

Butler

KANSAS

Sec. 3 Twp. 29 R. 6E ✓

Well No. #3 Meed Farm

Dunn & Strait Company


Dunn & Strait Contractor

330 Ft. from N. Line

_____ Ft. from S. Line

990 Ft. from E. Line

_____ Ft. from W. Line

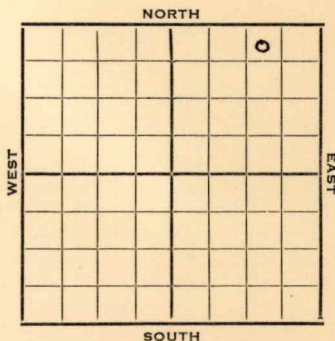

NW NE NE

1952

Elev. 1445'

REPORT

5/28

Spud 5-24-52
8" @ 70'
Drlg. 380'

6/18

Spud 5-24-52
Oil well TD 2849' - 8" @ 70
KC 2190' Miss 2836' TD 2849'
5" @ 2840 CO to 2849' Stratofrac.
S/1½ BOPH
Comp. 25 BOPD

COMPLETED

County **Butler** State **Kansas**
 Sec. **3** (Blk.) **29** (Sur.) **6E** Map No.

Operator **Dunn & Strait**

Well No. **3** Farm **Need**

Elev. Location **NW NE NE**

FIRST REPORT

330 Ft. From **N** Line **NE**

990 Ft. From **E** Line Quarter

1st. Report **MAY 28 1952**

Completion

Remarks

Dunn & Strait - Contr.

Spudding Date **5-24-52**

Drlg. Data

8" @ 70 Drlg. 380

J. G. McGEHEE

County

State

Kansas

Sec.

3

(Blk.)
(Twp.)

29

(Sur.)
(Rge.)

6 E

Map No.

Operator

Dunn & Strait

Well No.

3

Farm

Need

Elev.

1445

Location

NW NE NE

330 Ft. From

N Line

NE

990 Ft. From

E Line

Quarter

1st. Report

Completion

JUN 18 1952

Remarks

Dunn & Strait - Contr.

Spudding Date

5-24-52

Drlg. Data

Oil well

TD 2849

8"

@ 70

KC 2190

Miss. 2836

TD 2849

5" @ 2840

CO to 2849

Stratofrac

S/ $1\frac{1}{2}$ boph

Comp. 25 b opd

J. G. McGEHEE