

KANSAS

Rice

Form 51-5M-7-40-Place

O. W. P. B.


Section 30 Township 18S Range 7-W

Well No. 7 Meyer

Company Continental

Geneseo Pool

NORTH

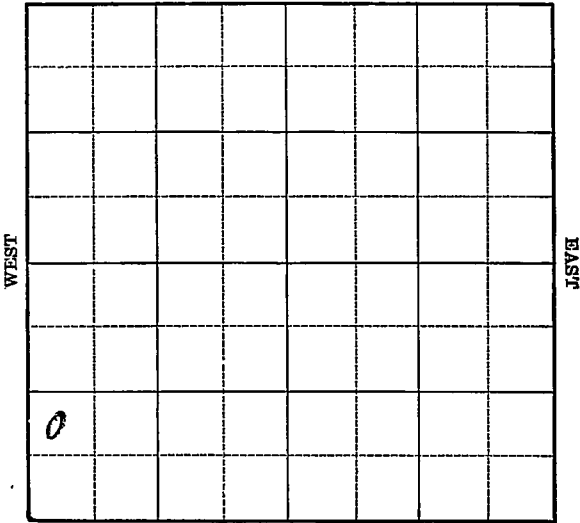

SOUTH

Sec. 30 Twp. 18 S R. 7-W

Well No. #7 Meyer Farm _____

Continental Company


(Geneseo)

_____ Ft. from N. Line

990 Ft. from S. Line

_____ Ft. from E. Line

330 Ft. from W. Line

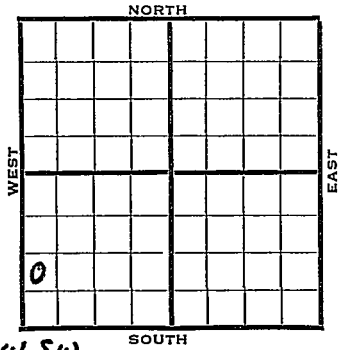

Elev. 1738

NWSWSW

SOUTH

1941	REPORT
1/15	Derrick.
1/23	"
1/30	10" - 197' Drlg. 1840'
2/6	Simpson sand 3158'
	SO 3171-78' & SO&W. 3214-18'
	Arb. 3246 TD 3251' 7" - 3247'
	RUST.
2/13	"
2/20	"
2/26	Arb. 3246'
	7" - 3247'
	T.D. 3251'
	Pump 210 oil & 21 water,
	potential. 40.1 Gravity
	COMPLETED
	OVER

1954
12/8

O. W. P. B.

Old Inf - Elev. 1738' DF
Lans 2810', Simp 3158', Arb. 3246'
OTD 3251'
7" @ 3247'
NEW INFO - PB 3236'
Perf 3223-32', 2 sd frac
P 11 BO NW 18 hrs.
38 degrees pumps off
complete

FIRST REPORT
&
COMPLETED

O. W. P. B.

County Rice State Kansas

Sec. 30 (Blk. 18S) (Sur. 7W) (Twp. 18S) (Rge. 7W) Map No.

Operator Continental

Well No. 7 Farm Meyer

Elev. Location NW SW SW

990 Ft. From S Line

330 Ft. From W Line SW Quarter

Ist. Report DEC 8 1954

Completion DEC 8 1954

Remarks (OWPB)

Spudding Date O. W. P. B.

Drlg. Data Genesee

Old Inf - Elev 1738 DF, Lans 2810,
Simp 3158, Arb 3246, OTD 3251, 7" @
3247 New Info - PB 3236, Perf 3223-
32, 2 sd frac, P 11 BO NW 18 hrs
38 degrees pumps off, COMPLETE

FABEN GILSTRAP