

DX 78-1

Butler


KANSAS

Section 4 Township 28 Range 7 E

Well No. # 1 Semisch

Company Augusta Oil

NORTH

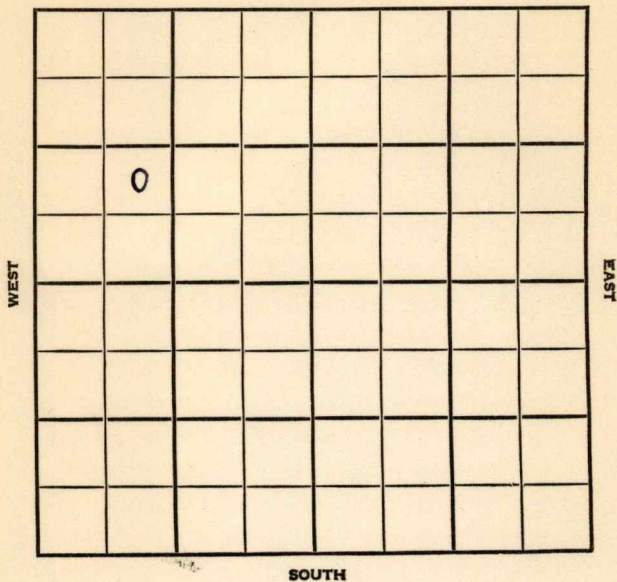

SOUTH

Butler KANSAS

SEC. 4 TWP. 28 R. 7 E

WELL NO. # 1 Semisch FARM

COMPANY Augusta Oil

CONTRACTOR Co. tools


DeMoss Pool

990 Ft. from N. Line

990 Ft. from S. Line

990 Ft. from E. Line

990 Ft. from W. Line

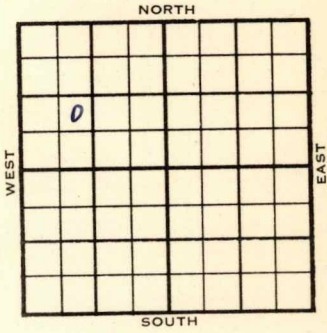

NE SW NW

1954 ELEVATION REPORT

12/15 Spud 12-4-54
 8" @ 88 Bart. 2684' Miss. 2754'
 TD 2785' D & A

FIRST REPORT
 ↙
ABANDONED

