

KANSAS


Rice

FORM 51 5M 4-41 PETROL

Section 30 Township 18 Range 7W

Well No. #11 Meyer

Company Continental

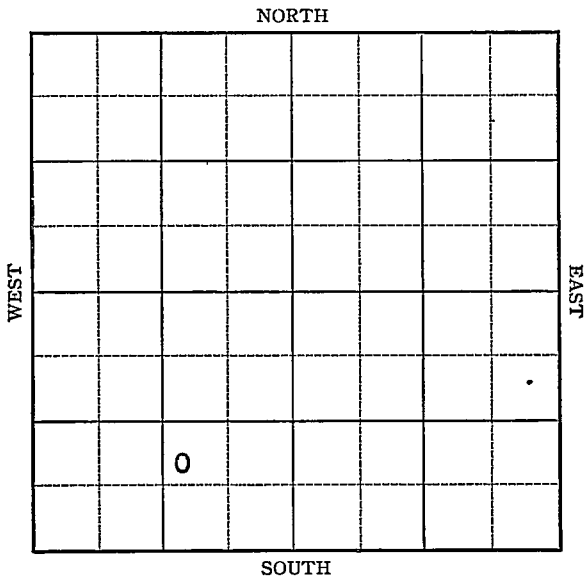

Map No. 45 Sec. 30 Twp. 18 R. 7WWell No. 11 MeyerContinental

Company

FIRST REPORT

Contractor

SECTION PLAT

NW SE SW

 Ft. from N. Line990 Ft. from S. Line990 Ft. from E. Line Ft. from W. Line

GENESEO POOL

RECORD

Location Cased in., ft.Rig up Sand

Drilling and Remarks:

Gas 10" - 203Oil WOCTotal Depth

PRODUCTION

1st 24 hrs. Nat. 1st 24 hrs. after shot Gas Cu. Ft.Dry Hole Abandoned

Date

SEP 3 1941 19S. I. LEWIS Scout

Map No. K-45 Sec. 30 Twp. 18 R. 7WWell No. 11 MeyerContinental CompanyCOMPLETION Contractor

SECTION PLAT

NW SE SW

 Ft. from N. Line990 Ft. from S. Line990 Ft. from E. Line Ft. from W. Line

GENESEO POOL

	o		

Location Rig up

Drilling and Remarks:

Ar 832026" @ 32031000 acidEch 834Max 3000405 gr

RECORD

Cased in., ft.Sand Gas Oil Total Depth 3210

PRODUCTION

1st 24 hrs. Nat. 1st 24 hrs. after shot Gas Cu. Ft.Dry Hole Abandoned

Date

SEP 24 1941 19 S. J. LEWIS Scout