

KANSAS

Butler

Section 4 Township 28 Range 7E

Well No. 1 Wilson

Company 17-KGS/Drll
J & M Drlg

Misc.
NORTH

WEST

EAST

SOUTH

KANSAS Butler ✓

Sec. 4 Twp. 28 R. 7E

Well No. 1 Wilson Farm

H & M Drlg. Company

Misc.


Ft. from N. Line

990 Ft. from S. Line

Ft. from E. Line

660 Ft. from W. Line

C N L SW SW

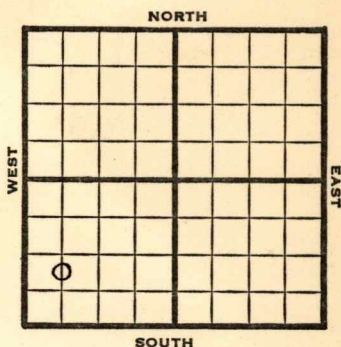

1948

E~~2~~i 1407'

R E P O R T

9/1

15" @ 145'
Drlg 415'

9/8

13" @ 775'
Drlg. 1330'

9/14

10" @ 1566'
8" @ 1960'
KC 2023'
Drlg. 2140'

9/21

"

9/29

TD 2766'
Miss 2720'
Aband.

ABANDONED

Butler County Kansas State


Map No. Sec. 4 Twp. 28 R. 7E

Well No. 1 Wilson

H. & M. Drlg. Company

FIRST REPORT
Contractor
C N L SW SW

SECTION PLAT

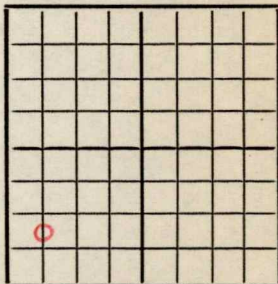

Ft. from N. Line

990 Ft. from S. Line

Ft. from E. Line

660 Ft. from W. Line

Miscellaneous

Remarks:

15" @ 145 drlg. 415

Date

SEP 1 1948

Scout

S. J. LEWIS

Map No. 10 Sec. 4 Twp. 28 R. 7EWell No. 1 WilsonH. & M. Drlg. Company**ABANDONED**

Contractor

C N L SW SW

E. 1407
SECTION PLAT Ft. from N. Line990 Ft. from S. Line Ft. from E. Line660 Ft. from W. Line

4			

Butler CountyLocation Rig up

Drilling and Remarks:

Miss 2720

RECORD

Cased in., ft.Sand Gas Oil Total Depth 2766

PRODUCTION

1st 24 hrs. Nat. 1st 24 hrs. after shot Gas Cu. Ft.Dry Hole Abandoned

Date

SEP 29 194819S. J. LEWIS

Scout