

Rice

KANSAS

30

18

7W

SECTION _____ TOWNSHIP _____ RANGE _____


#1 Peverly

WELL NO. _____

Messman & Rinehart

COMPANY _____

NORTH

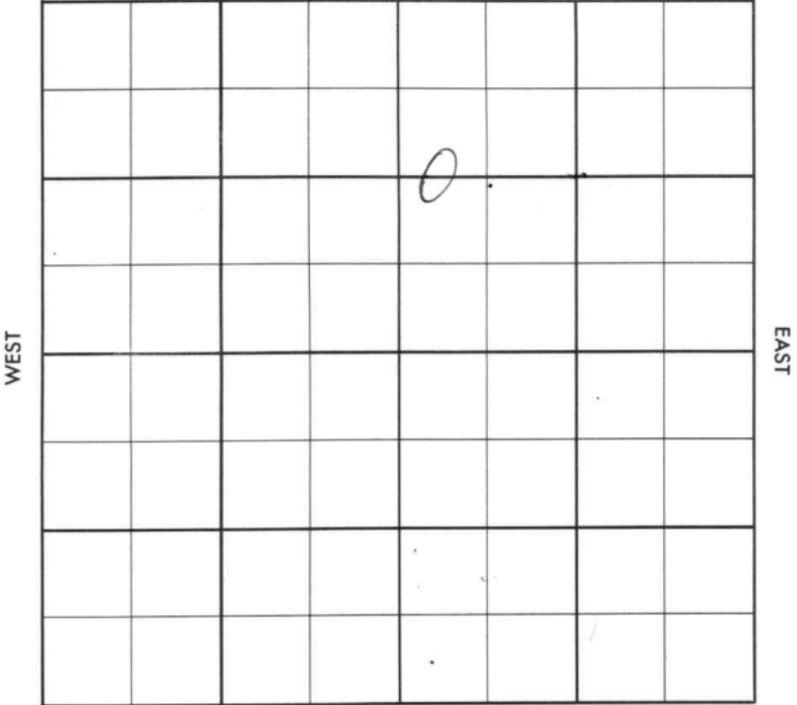

SOUTH

WEST

EAST

County Rice Elev. _____
 Sec. 30 Twp. 18 Rgs. 7W
 Company Messman & Rinehart
 FarmName Peverly No. 1

TOPS	DEPTH	LOG	DATUM	Loc. in Sec.																								
Anh.				C W $\frac{1}{2}$ W $\frac{1}{2}$ NE																								
TP.																												
H.																												
Tr.																												
Dg.																												
BL.																												
L.				Geol. _____																								
K.C.				Contr. _____																								
B.K.C.																												
Ce.				<u>Graham-Micha</u>																								
C.				Pool _____																								
M.																												
M.																												
K.																												
Mz.				<u>Genesee</u>																								
Me.				<table border="1"> <tr> <td></td> <td></td> <td></td> </tr> </table>																								
V.																												
S.																												
S.																												
A.																												
R.																												
PE.																												
G.																												
T.D.																												

FIRST REPORT
 DEC 12 '56

Date Comm. 12-9-56
8" @ 196/130

18

Co.
 Sec.
 T.
 R.

Co.

County Rice Elev. 1699
 Sec. 30 Twp. 18 Rge. 7W
 Company Messner & Rinehart
 Farm Name Peverly No. 1

TOPS	DEPTH	LOG	DATUM	Loc. in Sec.
Anh.				C W $\frac{1}{2}$ W $\frac{1}{2}$ NE
TP.				
H.	2604			
Tr.				
Dg.				
Bl.				
L.	2764			Geol. _____
K.C.				Contr. _____
B.K.C.				Graham-Michaeli
Ce.				Pool _____
C.				Geneseo
M.				
M.				
K.				
Mz.				
Ma.				
V.				
S.	sd 3170-82			FEB 6 '57
S.				
A.	3205			
R.				
Pe.				
G.				COMPLETE
T.D.	3211			

5

No.

Sec.

T.

R.

Date Comm. 12-9-56

8" @ 196/130 DEC 19 '56 DST 2778-2829

1 hr 50' Md (VSSO) BHP not record

DST 3162-93 DEC 26 '56 op 30" rec

5' Md (SSO) BHP 510/15

5 1/2 @ 3211/50 MICT JAN 2 '57 24/

3171-77 4 GMW w/SSG mat.

Frac 6x5 Pop P. Ld.

JAN 9 '57 P. 17 BO + 154 BW in

3 days JAN 16 '57 JAN 25 '57 JAN 30 '57 FEB 6 '57

P. 10 Bopd + 35 Bwppd.