

Section 3 Township 29 Range 6EWell No. #4 NeedCompany Dunn & Strait

NORTH

0							

WEST

EAST

SOUTH

Butler

KANSAS



Sec. 3 Twp. 29 R. 6E

Well No. #4 Need Farm

Dunn & Strait Company

Contractor


Ft. from N. Line

330' Ft. from S. Line

Ft. from E. Line

330' Ft. from W. Line

SW SW NW

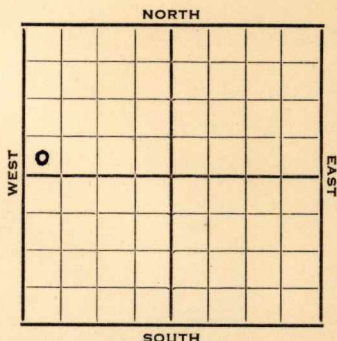

1952

Elev. 1419' REPORT

6/18

Location

7/2

Spud 6-19-52

Oil well - TD 2821' 8" @ 87

Bart. 2776' TD 2788' 5" @ 2780

DD 2821' Hydro.

Comp. F/25 BOPD

COMPLETED

County **Butler** State **Kansas**

Sec. **3** (Blk.) **29** (Sur.) **6E** Map No.

Operator Dunn & Strait

Well No. 4 Farm Wood

Elev.	Location	SW	SW	NW
-------	----------	----	----	----

330 Ft. From S Line NW

330 Ft. From W Line Quarter

1st. Report JUN 18 1952

Completion

Remarks

Spudding Date _____

Drlg. Data

Location


J. G. McGEHEE

County Butler State Kansas
 Sec. 3 (Blk.) 29 (Sur.) 6E Map No.

Operator Dunn & Strait

Well No. 4 Farm Need

Elev. 1419 Location SW SW NW

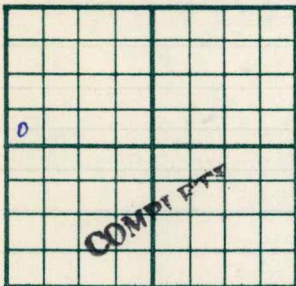

330 Ft. From S Line NW

330 Ft. From W Line Quarter

1st. Report

Completion JUL 2 1952

Remarks

Spudding Date 6-19-52

Drlg. Data Oil well TD 2821

8" @ 87 Bart. 2776 TD 2788

5" @ 2780 DD 2821 Hydro.

Comp. F/ 25 bopd