

Section 3 Township 29 Range 6EWell No. 7 NeedCompany Dunn & Strait

NORTH

				0			

WEST

EAST

SOUTH

Butler
29

KANSAS ✓

Sec. 3 Twp. 29 R. 6E

Well No. #7 Need Farm

Dunn & Strait

Company

Dunn & Strait

Contractor


990 Ft. from N. Line

Ft. from S. Line

Ft. from E. Line

330 Ft. from W. Line

SW NW NE

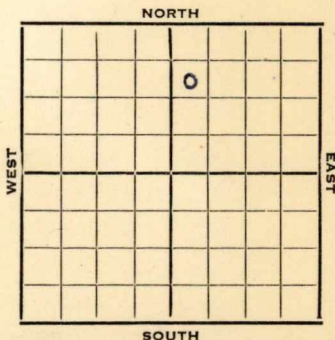

1952 Elev. 1436' REPORT

12/10 MIM

1953

1/14

Oil Well TD 2846'

8" @ 75

Bart 2809

TD 2811

5" @ 2811

DD 2846

Comp 25 bopd

COMPLETED

J. G. McGEHEE

1000
 900
 800
 700
 600
 500
 400
 300
 200
 100
 0