

KANSAS

Rice


FORM 51 5M 2-38 TPCO.

PA

Section 30 Township 18 Range 7-W

Well No. #4 Meyer

Company Continental

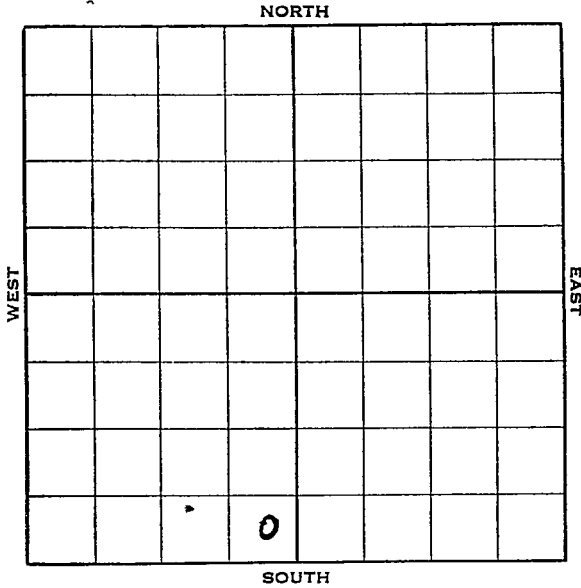

Sec. 30 Twp. 18 R. 7-W

Well No. #4 Meyer Farm

Continental Company


 Ft. from N. Line

330 Ft. from S. Line

255 Ft. from E. Line

 Ft. from W. Line

Elev. 1697

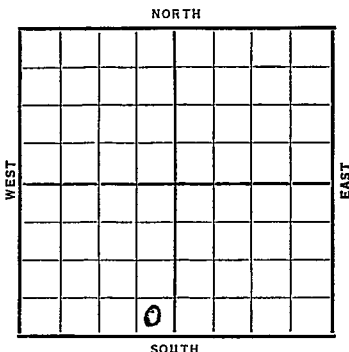

Date	REPORT
1938	
10/19	R. R.
10/28	10" - 213'. Dlg. 770'.
11/4	Drilg. 3025'.
11/12	Arb. 3163-65'. 7" - 3164'. RUST.
11/16	7" - 3164'.
	Arb. 3163'.
	T. D. 3180'.
	3000 acid.
	Potential 2057 bbls.
	COMPLETED

Rice **KANSAS**Map No. 45 Sec. 30 Twp. 18 R. 7WWell No. 4 MeyerContinental Company

Contractor

FIRST REPORT**SE SW** Ft. from N. Line330 Ft. from S. Line255 Ft. from E. Line Ft. from W. Line**SECTION PLAT**

Location Rig up

Drilling and Remarks:

RR**RECORD**Cased in., ft.Sand Gas Oil Total Depth **PRODUCTION**1st 24 hrs. Nat. 1st 24 hrs. after shot Gas Cu. Ft.Dry Hole Abandoned

Date

OCT 19 1938 19H. D. Hatfield Scout

Rice **KANSAS**

Map No. 45 Sec. 30 Twp. 18 R. 7W

Well No. 4 Meyer

Continental

Company

Contractor

COMPLETED

SE SW

_____ Ft. from N. Line

330 Ft. from S. Line

255 Ft. from E. Line

_____ Ft. from W. Line

SECTION PLAT

0

Location _____

Rig up _____

Drilling and Remarks:

300 acid

RECORD

Cased 7 in., 3164 ft.

Sand Arb 3163

Gas _____

Oil _____

Total Depth 3180

PRODUCTION

1st 24 hrs. Nat. _____

1st 24 hrs. after shot _____

Gas _____ Cu. Ft.

Dry Hole _____

Abandoned _____

Pot 2057

Date

NOV 16 1938

H. D. Hatfield Scout