

KANSAS

Form 51-5M-7-40-Palace


Rice

Section 30 Township 18 Range 7-W

Well No. #8 Meyer

Company Continental

NORTH Geneseo Pool

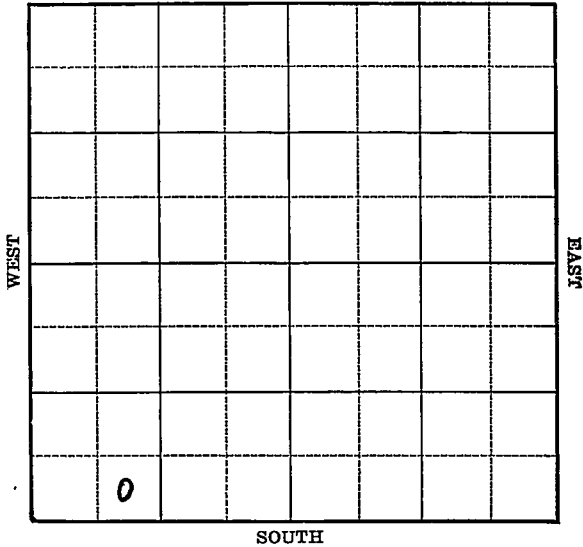

Sec. 30 Twp. 18 R. 7-W

Well No. #8 Meyer Farm

Continental Company

(Geneseo)


 Ft. from N. Line

330 Ft. from S. Line

 Ft. from E. Line

990 Ft. from W. Line

Elev. 1717

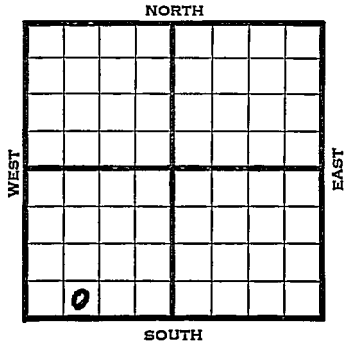

1941	REPORT
3/12	Derrick.
3/20	9" - 203' Drlg. 2220'
3/27	Arb. 3193-99' T.D.
	6" - 3194' RUST.
4/2	Arb. 3193'
	6" - 3194'
	T.D. 3205'
	2000 acid.
	Echometer potential 12,764 bbls.
	Maximum 3000 bbls.
	40.1 Gravity
	COMPLETED

Map No. 45 Sec. 30 Twp. 18 R. 7W

Well No. 8 Meyer

Continental Company

COMPLETE Contractor

SE SW SW

_____ Ft. from N. Line

330 Ft. from S. Line

_____ Ft. from E. Line

990 Ft. from W. Line

GENESEO POOL

SECTION PLAT

Location _____

Rig up _____

Drilling and Remarks:

Cr 8193
6" @ 3194
2000 acid
Echo Prod 12764
Max 3000
40' Str.

RECORD

Cased _____ in., _____ ft.

Sand _____

Gas _____

Oil _____

Total Depth 3205

PRODUCTION

1st 24 hrs. Nat. _____

1st 24 hrs. after shot _____

Gas _____ Cu. Ft.

Dry Hole _____

Abandoned _____

Date

APR 2 1941

S. J. LEWIS

Scout