

KANSAS

FORM 51 5M 4-41 PETROL

Rice


Section 30 Township 18 Range 7-W

Well No. #9 Meyer

Company Continental

Geneseo Pool

NORTH

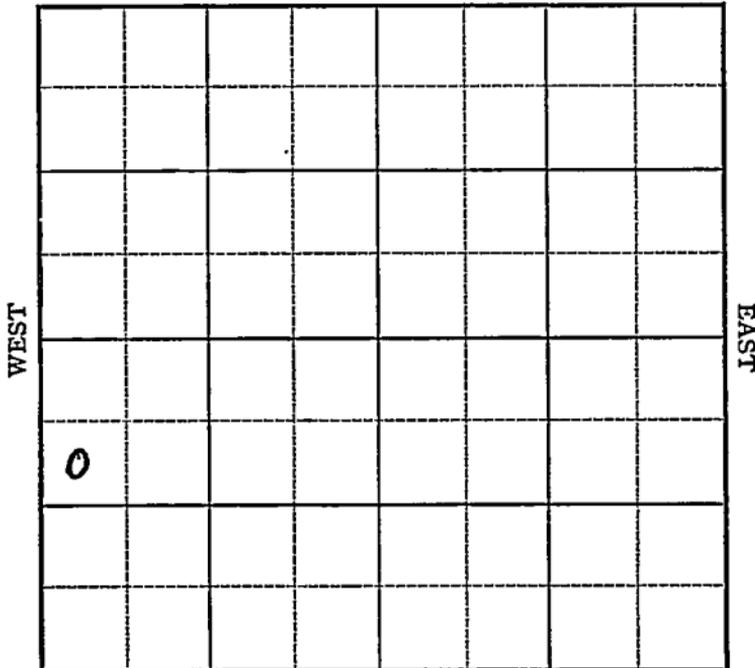

SOUTH

7W

Map No. _____ Sec. 30 Twp. 18 R. 9W

Well No. 9 Meyer

Continental Company

FIRST REPORT Contractor

SECTION PLAT

SE NW SW

990 Ft. from N. Line

_____ Ft. from S. Line

_____ Ft. from E. Line

330 Ft. from W. Line

GENESEO POOL

Location _____

Rig up _____

Drilling and Remarks:

Drlg. 206

RECORD

Cased _____ in., _____ ft.

Sand _____

Gas _____

Oil _____

Total Depth _____

PRODUCTION

1st 24 hrs. Nat. _____

1st 24 hrs. after shot _____

Gas _____ Cu. Ft.

Dry Hole _____

Abandoned _____

Date


4. 9 1941

19

S. J. LEWIS

Scout

Check range

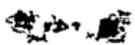

Misc Small Maps
Cards
Tracing
France Map
Scarborough Map
Moody Map
Geological Dept.
Moody Plat Book

Handwritten signature/initials, possibly 'DAN' or 'DAN 19', written over the form.

Map No. 45 Sec. 30 Twp. 18 R. 7W

Well No. 9 Meyer

Continental Company

CORRECTION Contractor

SECTION PLAT

SE NW SW

990 Ft. from N. Line

_____ Ft. from S. Line

_____ Ft. from E. Line

330 Ft. from W. Line

GENESEO POOL

Location _____

Rig up _____

Drilling and Remarks:

Reported
Range 9W.

RECORD

Cased _____ in., _____ ft.

Sand _____

Gas _____

Oil _____

Total Depth _____

PRODUCTION

1st 24 hrs. Nat. _____

1st 24 hrs. after shot _____

Gas _____ Cu. Ft.

Dry Hole _____

Abandoned _____

Date

APR 18 1941 19

S. J. LEWIS Scout

Map No. 45 Sec. 30 Twp. 18 R. 7WWell No. 9 MeyerContinental Oil CompanyCOMPLETED Contractor

SECTION PLAT

SE NW SW

990 Ft. from N. Line

_____ Ft. from S. Line

_____ Ft. from E. Line

330 Ft. from W. Line

GENESEO POOL

Location _____

Rig up _____

Drilling and Remarks:

*Cor & 172.**6" @ 3173**2000 Acid**Echo P & 6306**Max 3000**40' Gr.*

RECORD

Cased _____ in., _____ ft.

Sand _____

Gas _____

Oil _____

Total Depth 3210

PRODUCTION

1st 24 hrs. Nat. _____

1st 24 hrs. after shot _____

Gas _____ Cu. Ft.

Dry Hole _____

Abandoned _____

Date

APR 30 1941 19

S. J. LEWIS Scout