


Section 14 Township 15 Range 14 W

Well No. # 8 Tittle (D)

Company Cities Service Oil

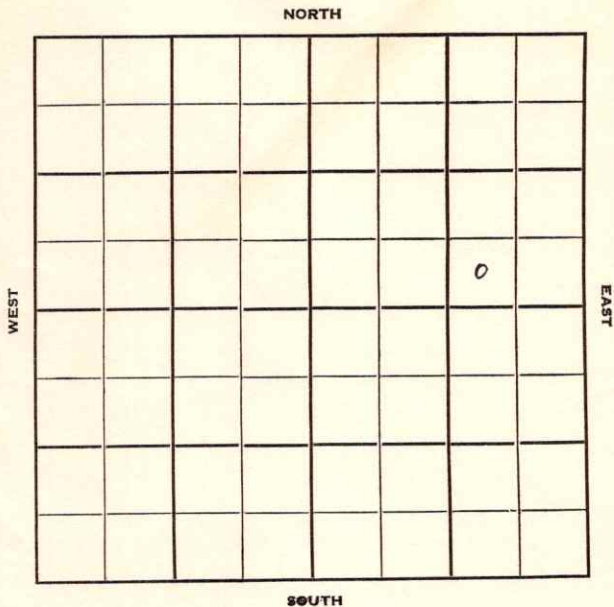

Russell

KANSAS

Sec. 14 Twp. 15 R. 14W

Well No. #8 Tittle (D) Farm

Cities Service Oil Company

Contractor


\_\_\_\_\_ Ft. from N. Line

330 Ft. from S. Line

1010 Ft. from E. Line

\_\_\_\_\_ Ft. from W. Line

SW SE NE

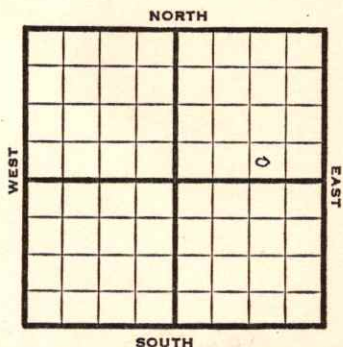

1951

Elev. 1890

REPORT

10/31

Trapp

11/21

Spud 10-30-51

Oil Well TD 3349

8" @ 532

Lans. 3090

Arb. 3345

TD 3349 5" @ 3346

Comp. 158 BOPD 7 bw

**COMPLETED**



County Russell State Kansas  
 Sec. 14 (Blk. 15) (Sur. 14W) (Twp.) 15 (Rge.) 14W Map No.  
 Operator Cities Service  
 Well No. 8 Farm Tittle "D"  
 Elev. 1890 Location SW SE NE


330 Ft. From S Line NE  
1010 Ft. From E Line Quarter  
 1st. Report  
 Completion NOV 21 1951  
 Remarks Trapp Pool

Spudding Date 10-30-51

Drlg. Data Oil well TD 3349  
8" @ 532 Lans. 3090 Arb. 3345  
TD 3349 5" @ 3346 Comp. 158 bopd 7 bw

J. E. TYRA