

KANSAS

Rice

FORM 51 5M 4-41 PETROL


Section 30 Township 18 Range 7-W

Well No. 10 A. H. Meyer

Company Continental

Geneseo pool

NORTH

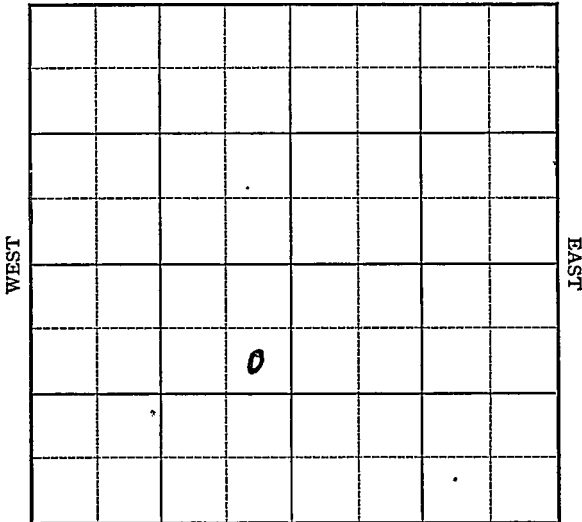

SOUTH

Map No. 45 Sec. 30 Twp. 18 R. 7W

Well No. 10 A.H.Meyer

Continental Company

GEORGE A. BROWN Contractor

SE NE SW

SECTION PLAT

990 Ft. from N. Line

_____ Ft. from S. Line

330 Ft. from E. Line

_____ Ft. from W. Line

GENESEO POOL

Location _____

Rig up _____

Drilling and Remarks:

Derrick

RECORD

Cased _____ in., _____ ft.

Sand _____

Gas _____

Oil _____

Total Depth _____

PRODUCTION

1st 24 hrs. Nat. _____

1st 24 hrs. after shot _____

Gas _____ Cu. Ft.

Dry Hole _____

Abandoned _____

Date

AUG 13 1941 19

S. J. LEWIS Scout

Map No. 45 Sec. 30 Twp. 18 R. 7W

Well No. 10 A.H. Meyer

Continental Company

Contractor

COMPLETED

SECTION PLAT

990 SE NE SW
Ft. from N. Line

_____ Ft. from S. Line

330 Ft. from E. Line

_____ Ft. from W. Line

GENESEO POOL

RECORD

Location _____

Rig up _____

Drilling and Remarks:

*Ar 3205 ;
6" @ 3206
4000 @ oil
Pump 130 P & X

405 Gr*

Cased _____ in., _____ ft.

Sand _____

Gas _____

Oil _____

Total Depth 3217

PRODUCTION

1st 24 hrs. Nat. _____

1st 24 hrs. after shot _____

Gas _____ Cu. Ft.

Dry Hole _____

Abandoned _____

Date

SEP 10 1941 19

S. J. LEWIS Scout