

KANSAS


Rice

Form 51-5M-7-40-Palace

Section 30 Township 18 Range 7-W

Well No. ~~#4~~ Poland #5

Company Continental

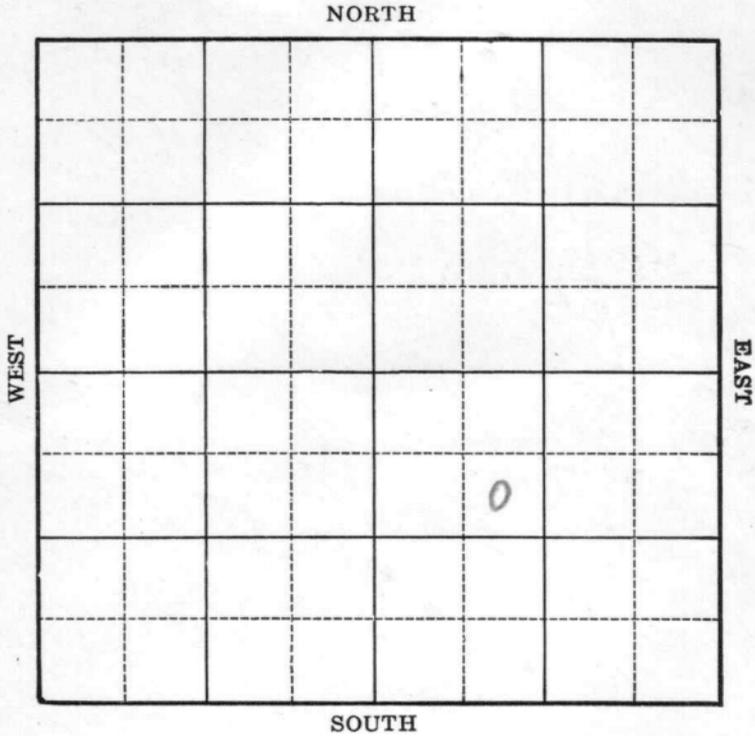

Sec. 30 Twp. 18 R. 7-W

Well No. #4 Poland #5 Farm _____

Continental Company

(Geneseo)


990 Ft. from N. Line

_____ Ft. from S. Line

_____ Ft. from E. Line

990 Ft. from W. Line

Elev. 1677

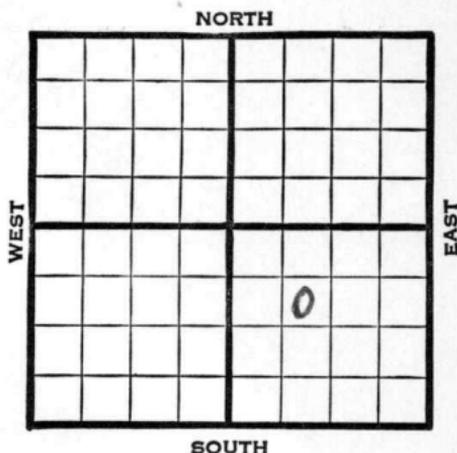

194	REPORT
2/5	Location
2/13	9" - 202' Drlg. 1800'
2/20	Arb. 3157-60' T.D. 6" - 3158'
	RUST.
2/27	T.D. 3167' 1000 acid.
3/5	Arb. 3157'
	6" - 3158'
	T.D. 3175'
	8000 acid.
	Potential 391 bbls., pump.
	40.1 Gravity
	COMPLETED

Map No. 45 Sec. 30 Twp. 18 R. 7W

Well No. 4 Poland

Continental

Company

FIRST REPORT

Contractor

SECTION PLAT

SE NW SE
990 Ft. from N. Line

_____ Ft. from S. Line

_____ Ft. from E. Line

990 Ft. from W. Line

		o	

GENESEO POOL

Location X

Rig up _____

Drilling and Remarks:

RECORD

Cased _____ in., _____ ft.

Sand _____

Gas _____

Oil _____

Total Depth _____

PRODUCTION

1st 24 hrs. Nat. _____

1st 24 hrs. after shot _____

Gas _____ Cu. Ft.

Dry Hole _____

Abandoned _____

Date

FEB 5 1941 19

S. J. LEWIS

Scout

Map No. 45 Sec. 30 Twp. 18 R. 7W

Well No. 5 Poland

Continental Company

CORRECTION Contractor

SE NW SE

SECTION PLAT

990 Ft. from N. Line

_____ Ft. from S. Line

_____ Ft. from E. Line

990 Ft. from W. Line

GENESEO POOL

Location _____

RECORD

Rig up _____

Drilling and Remarks:

Reported

as #4 Poland

Cased _____ in., _____ ft.

Sand _____

Gas _____

Oil _____

Total Depth _____

PRODUCTION

1st 24 hrs. Nat. _____

1st 24 hrs. after shot _____

Gas _____ Cu. Ft.

Dry Hole _____

Abandoned _____

Date

FEB 5 1941 19

S. J. LEWIS

Scout

Map No. 45 Sec. 30 Twp. 18 R. 7W

Well No. 5 Poland

Continental Company

Contractor

COMPLETED

SECTION PLAT

SE NW SE
990 Ft. from N. Line
_____ Ft. from S. Line
_____ Ft. from E. Line
990 Ft. from W. Line

		o	

GENESEO POOL

Location _____

Rig up _____

Drilling and Remarks:

*Cor 83157.
6" @ 3158.
4000 acid
Pump. 391 P.Y.
40' Gr.*

RECORD

Cased _____ in., _____ ft.
Sand _____
Gas _____
Oil _____
Total Depth 3125.

PRODUCTION

1st 24 hrs. Nat. _____
1st 24 hrs. after shot _____
Gas _____ Cu. Ft.
Dry Hole _____
Abandoned _____

Date

MAR 5 1941 19

S. J. LEWIS Scout