

Cowley
34

KANSAS ✓

Sec. 15 Twp. 34 R. 3E

Well No. #1 Stevenson "B" Farm

Absher & Booth Company

Springer & Harper Contractor


330 Ft. from N. Line

Ft. from S. Line

Ft. from E. Line

330 Ft. from W. Line

NW NW SE

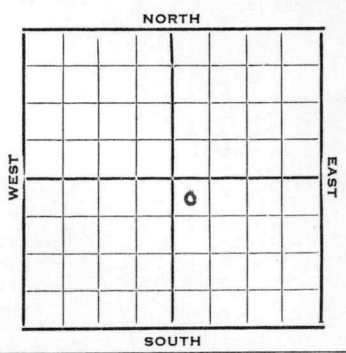

1953 ELEV. 1085' REPORT

2/4 Spud 1-28-53
8" @ 90
Drlg. 2280'

2/25 Spud 1-28-53
Oil Well
TD 3275
8" @ 90
Bart 3265
TD 3275
5" @ 3266
CO to 3275 Hydro
Comp. 1953 bopd

COMPLETED

