


Section 16 Township 34 Range 3E

Well No. 1 Chaplin

Company H & S Drlg

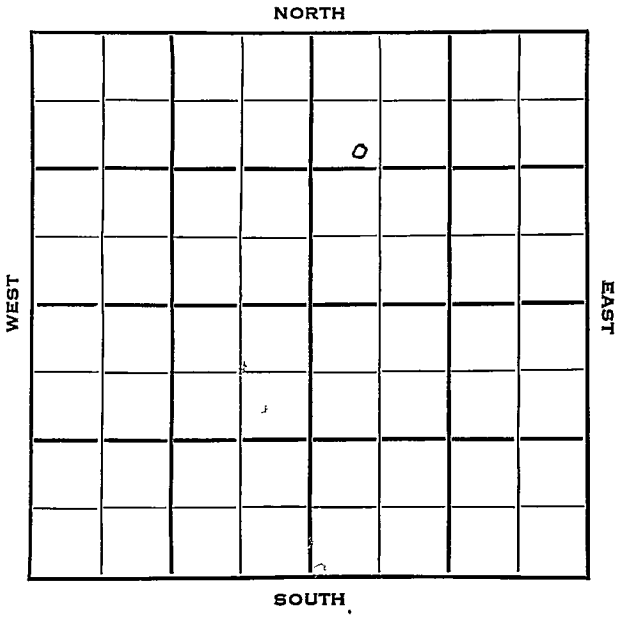

Cowley

KANSAS ✓

16

34

3E

Sec. \_\_\_\_\_ Twp. \_\_\_\_\_ R. \_\_\_\_\_

#1 Chaplin

Well No. \_\_\_\_\_ Farm \_\_\_\_\_

H & S Drlg.

Company \_\_\_\_\_

Empire Drlg.

Contractor \_\_\_\_\_

Harvey Pool

990

Ft. from N. Line


Ft. from S. Line

Ft. from E. Line

495

Ft. from W. Line

SE SW NW NE

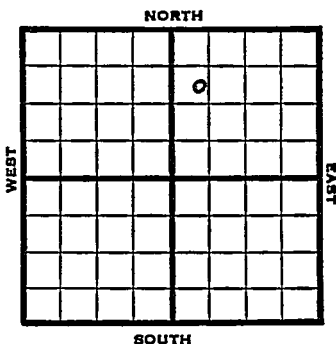

1953

Elev. 1081'

REPORT

4/1

8" @ 103'  
Drlg. 3185'

4/8

B&A  
TD 3341  
8" @ 103  
Stal 2135, Layton 2605, Lans 2785,  
Oswego 2990, Cherokee 3310, Bart  
3282, Bart sd 3292, Miss 3335  
TD 3341  
D&A

**ABANDONED**

County Cowley State Kansas

Sec. 16 (Blk. Twp.) 34 (Sur. Rge.) 3E Map No.

Operator H & S Drlg.

Well No. 1 Farm Chaplin

Elev. \_\_\_\_\_ Location SE SW NW NE


990 Ft. From N Line NE

495 Ft. From W Line Quarter

1st. Report APR 1 1953

Completion \_\_\_\_\_

Remarks \_\_\_\_\_

Empire Drlg. - Contr.

Spudding Date \_\_\_\_\_

Drlg. Data Harvey Pool

8" @ 103 drlg. 3185

