

Section 16 Township 34 Range 3E

Well No. #1 Musson (Musson)

Company J. H. Wagner

NORTH

WEST

EAST

0							

SOUTH

Cowley

KANSAS
O.W.W.O.

3E

Sec. 16 Twp. 34 R. 3E

Well No. #1 Musson Farm

J. H. Wagner Company

Smitherman & Cohen - Contr. Contractor

Baird


_____ Ft. from N. Line

330' Ft. from S. Line

_____ Ft. from E. Line

330' Ft. from W. Line

SW SW SW

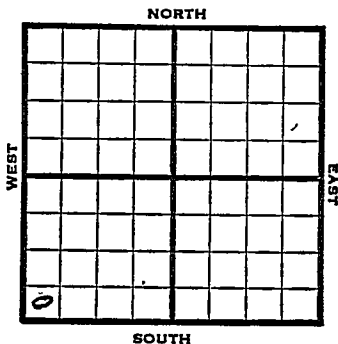

1952

Elev. 1154' REPORT

6/25

8" @ 83'

7/9

D&A TD 3416

8" @ 83'

Stal 2226-86 Layton 2657

DST 2656-64 opp 1 hr. Rec. 10' oil

115' wtr 900# KC 3060

Bart 3362 Miss Chat 3388

Miss Lime 3414-16 TD

D&A

ABANDONED

O.W.W.O.

1953

3/18

Sta. 2262, Layton 2657, KC 3060

Bart 3362, Miss, 3388, OTD 3416

4/8

Oil Well

TD 3416

Stal 2262, Layton 2657, KC 3060, Bart 3348, Miss 3388

OTD 3416

CO to 3416

5" @ 3416

96/3348-58, S/25 bopd D-hydro

F/25 boph

F/12 boph

Comp. 50 bopd

COMPLETED

