


Section 5 Township 28 Range 7-E

Well Number 2 - DeMoss "B"

Company Rex & Morris et al

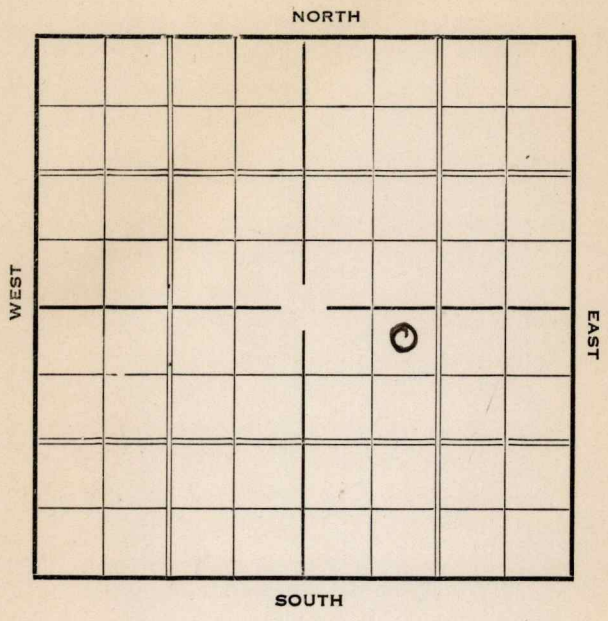

Butler KANSAS

Map No. 10 Sec. 5 Twp. 28 R. 7 ^EWell No. 2 - De Moss "B"Rex & Morris et al Company

Contractor

FIRST REPORT

SECTION PLAT

330 Ft. from N. Line

_____ Ft. from S. Line

_____ Ft. from E. Line

990 Ft. from W. Line

		0	

Location _____

Rig up _____

Drilling and Remarks:

12" 890D/g - 1205

RECORD

Cased _____ in., _____ ft.

Sand _____

Gas _____

Oil _____

Total Depth _____

PRODUCTION

1st 24 hrs. Nat. _____

1st 24 hrs. after shot _____

Gas _____ Cu. Ft.

Dry Hole _____

Abandoned _____

Date

MAY 19 1937

19

H. D. Hatfield

Scout

Butler KANSAS

Map No. 10 Sec. 5 Twp. 28 R. 7EWell No. 2-De moss "B"Rex & Morris et al Company

Contractor

ABANDONED

SECTION PLAT

		0	

330 Ft. from N. Line

_____ Ft. from S. Line

_____ Ft. from E. Line

990 Ft. from W. Line

Location _____

Rig up _____

Drilling and Remarks:

HFW

D & A

RECORD

Cased BARTIN 2765 ft.Sand MISS 2827

Gas _____

Oil _____

Total Depth 2827

PRODUCTION

1st 24 hrs. Nat. _____

1st 24 hrs. after shot _____

Gas _____ Cu. Ft.

Dry Hole _____

Abandoned _____

Date

JUN 9 1937 19 H. D. Hatfield Scout