


Map No. 11 Sec. 17 Twp. 34 R. 3

Well No. 1 Baird Farm  
Shwell Et al Company

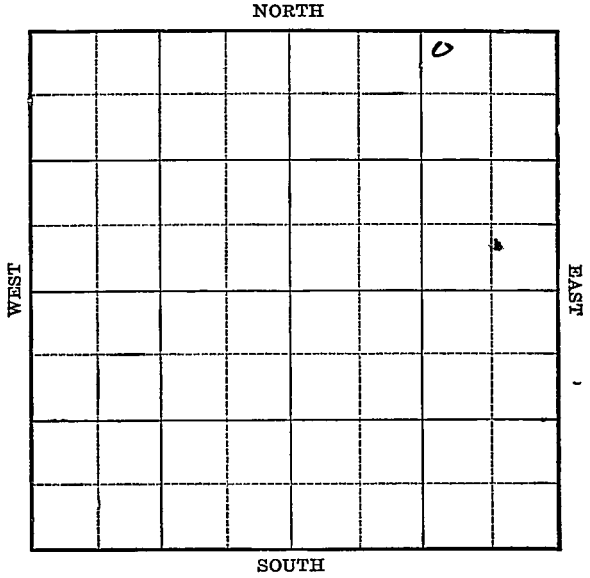

<p>Location _____</p> <p>Drilling Remarks:</p> <p>_____</p> <p>_____</p> <p>_____</p> <p>_____</p> <p>_____</p> <p>_____</p> <p>_____</p> <p>_____</p> <p>_____</p> <p style="text-align: center;"><b>RECORD</b></p> <p>Cased _____ in. _____ ft.</p> <p>Sand _____</p> <p>Gas _____</p> <p>Oil _____</p> <p>Total Depth _____</p>	<p>Rig Up _____</p> <p>Drilling Remarks:</p> <p>_____</p> <p>_____</p> <p>_____</p> <p>_____</p> <p>_____</p> <p>_____</p> <p>_____</p> <p>_____</p> <p>_____</p> <p style="text-align: center;"><b>PRODUCTION</b></p> <p>1st 24 hrs. Nat. _____</p> <p>1st 24 hrs. after shot _____</p> <p>Gas _____ cu. ft.</p> <p>Dry Hole _____</p> <p>Abandoned _____</p>
--	--

Map No. K Sec. 17 Twp. 34 R. 3

Well No. #1 Farm \_\_\_\_\_


Elwell et al Company

330 Ft. from N. Line

\_\_\_\_\_ Ft. from S. Line

1990 Ft. from E. Line

\_\_\_\_\_ Ft. from W. Line

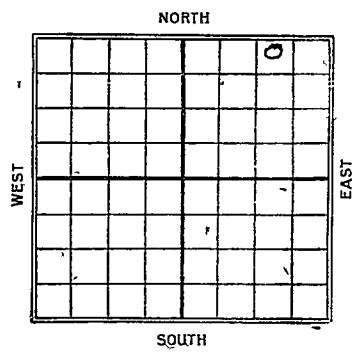

Date	REPORT
1924	
8/6	Location
11/26	3 <sup>rd</sup> Gas 1870.
	Will drill ahead
12/17 1925	Rig burned - Rig in use
1/28	S.D. 1880
5/15	Dry at depth 3800.

Map No. **KANSAS** / Sec. 17 Twp. 34 R. 3

Well No. #1

C. Swell et al Company

Contractor

**FIRST REPORT**

**SECTION PLAT**

330 Ft. from N. Line

\_\_\_\_\_ Ft. from S. Line

940 Ft. from E. Line

\_\_\_\_\_ Ft. from W. Line

			0

Location ✓ ✓

Rig up \_\_\_\_\_

Drilling and Remarks:

**RECORD**

Cased \_\_\_\_\_ in., \_\_\_\_\_ ft.

Sand \_\_\_\_\_

Gas \_\_\_\_\_

Oil \_\_\_\_\_

Total Depth \_\_\_\_\_

**PRODUCTION**

1st 24 hrs. Nat. \_\_\_\_\_

1st 24 hrs. after shot \_\_\_\_\_

Gas \_\_\_\_\_ Cu. Ft.

Dry Hole \_\_\_\_\_

Abandoned \_\_\_\_\_

Date

AUG 6 1924

**M. A. BENEAR**

192

Scout

Map No. 1 **KANSAS** Sec. 17 Twp. 34 R. 2

Well No. 1 Baird

6 Wellbital Company

Contractor

# ABANDONED SECTION PLAT

330 Ft. from N. Line

\_\_\_\_\_ Ft. from S. Line

990 Ft. from E. Line

\_\_\_\_\_ Ft. from W. Line

			0

Location \_\_\_\_\_

Rig up \_\_\_\_\_

Drilling and Remarks:

1049  
3800'

## RECORD

Cased \_\_\_\_\_ in., \_\_\_\_\_ ft.

Sand \_\_\_\_\_

Gas \_\_\_\_\_

Oil \_\_\_\_\_

Total Depth \_\_\_\_\_

## PRODUCTION

1st 24 hrs. Nat. \_\_\_\_\_

1st 24 hrs. after shot \_\_\_\_\_

Gas \_\_\_\_\_ Cu. Ft.

Dry Hole \_\_\_\_\_

Abandoned \_\_\_\_\_

Date

**MAY 16 1925**

\_\_\_\_\_ 192\_\_\_\_\_

**M. A. BENEAR**

Scout

Cowley

FORM 26 250, BKS. 4-28 WESTERN

K1 KANSAS SEC. 17 TWP. 34S R. 3E

WELL NO. E. B. Shover COMPANY

CONTRACTOR

ABANDONED

SECTION PLAT


\_\_\_\_\_ FT. FROM N. LINE  
 \_\_\_\_\_ FT. FROM S. LINE  
 \_\_\_\_\_ FT. FROM E. LINE  
 \_\_\_\_\_ FT. FROM W. LINE

RECORD

LOCATION \_\_\_\_\_

CASED \_\_\_\_\_ IN. \_\_\_\_\_ FT.

RIG UP \_\_\_\_\_

SAND \_\_\_\_\_

DRILLING AND REMARKS:

GAS \_\_\_\_\_

OIL \_\_\_\_\_

TOTAL DEPTH 3800

OK

PRODUCTION

1ST 24 HRS. NAT. \_\_\_\_\_

1ST 24 HRS. AFTER SHOT \_\_\_\_\_

GAS \_\_\_\_\_ CU. FT.

DRY HOLE ✓

ABANDONED ✓

DATE

5/22 1925

SCOUT

