

KANSAS


Butler

Form 51—5M—7-39—Palace

Section 5 Township 28 Range 7-E

Well No. #3 DeMoss "B"

Company Rex & Morris

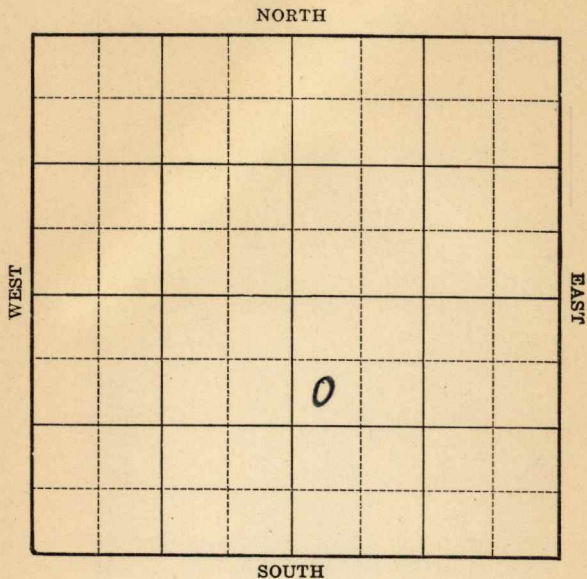

Sec. 5 Twp. 28 R. 7-E

Well No. #3 Demoss "B" Farm

Rex & Morris _____ Company

(Beaumont)


990 Ft. from N. Line

_Ft. from S. Line

_Ft. from E. Line

330 Ft. from W. Line

Elv. 1453

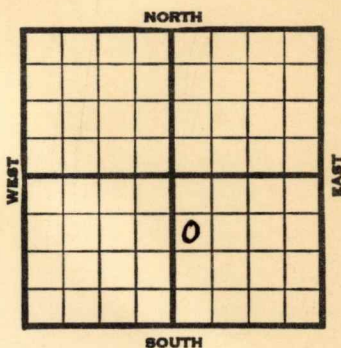

1939	REPORT
12/6	Drlg. 370'
12/14	12" - 905' Drlg. 1235'
12/21	10" - 1605' Drlg. 1950'
12/28	8" - 2190' Drlg. 2265'
1940	
1/4	" " " " "
1/10	Bart. 2706'
	7" - 2706'
	T.D. 2742'
	Shot 100 qts. 2712-42'
	Pump 40 bbls.
	COMPLETED

KANSAS

Butler

Map No. 10 Sec. 5 Twp. 28 R. 7EWell No. 3 DeMoss "B"Rex & Morris

Company

Contractor

FIRST REPORT

SW NW SE

990 Ft. from N. Line Ft. from S. Line Ft. from E. Line330 Ft. from W. Line**BEAUMONT POOL****SECTION PLAT**

Location Rig up

Drilling and Remarks:

Drlg. 370

RECORDCased in., ft.Sand Gas Oil Total Depth **PRODUCTION**1st 24 hrs. Nat. 1st 24 hrs. after shot Gas Cu. Ft.Dry Hole Abandoned

Date

DEC 6 1939 19

S. J. LEWIS Scout

Butler **KANSAS**Map No. 10 Sec. 5 Twp. 28 R. 7EWell No. 3 DeMoss "B"Rex & Morris

Company

Contractor

COMPLETED**SECTION PLAT**

SW NW SE

990 Ft. from N. Line Ft. from S. Line Ft. from E. Line330 Ft. from W. Line**BEAUMONT POOL**

Location Rig up

Drilling and Remarks:

*Bar 2706**2" @ 2706**1009 to 2712 - 42**Pump 40 1/2***RECORD**Cased in., ft.Sand Gas Oil Total Depth 2742**PRODUCTION**1st 24 hrs. Nat. 1st 24 hrs. after shot Gas Cu. Ft.Dry Hole Abandoned

Date

JAN 10 1940 19

S. J. LEWIS

Scout