

KANSAS

Form 51-5M-7-40-Palace

Rice

KANSAS KANSAS

W. P. B.

Section 30 Township 18 Range 7-W

Well No. #4 Poland

Company Continental

NORTH **Geneseo Pool**

| | | | | | | | |
|--|--|--|--|--|--|--|--|
| | | | | | | | |
| | | | | | | | |
WEST

EAST

SOUTH

0

O. W. P. B.

Sec. 30 Twp. 18 R. 7-W

Well No. #4 Poland Farm _____

Continental Company

(Geneseo)

_____ Ft. from N. Line


999 Ft. from S. Line

_____ Ft. from E. Line

990 Ft. from W. Line

NE SW SE

Elev. 1678

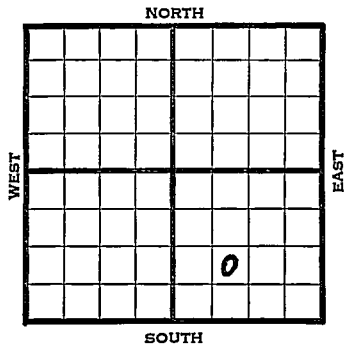

| 1941 | REPORT |
|--------------------|--|
| 3/12 | Derrick. |
| 3/20 | 9" - 206' Drlg. 2410' |
| 3/27 | Arb. 3155-59' T.D. 6" - 3156' RUST. |
| 4/2 | Arb. 3155' 6" - 3156' T.D. 3163' Echometer potential 7694 bbls. Maximum 3000 bbls. 40.1 Gravity |
| COMPLETED | |
| O. W. P. B. | |
| 1953 | |
| 9/2 | Lans. 2755' Simp. 3119' Arb. 3155' 6" @ 3156 OTD 3163 PB in Simp. & Lans. |
| 9/9 | CO 3163 PB 3135 Log. |
| 9/16 | Pipe Collapsed |

OVER

1953

#4 C.W. Poland.

9/23

D & A

TD 3163'

Lans. 2755, Simp 3119, Arb 3155,
6" @ 3156'

OTD 3163'

PB 3135 pipe collapsed

CO to 3020

D & A

ABANDONED

