


Section 31 Township 18 Range 7-W

Well No. 1 - Bolton

Company Sinclair ~~Prairie~~

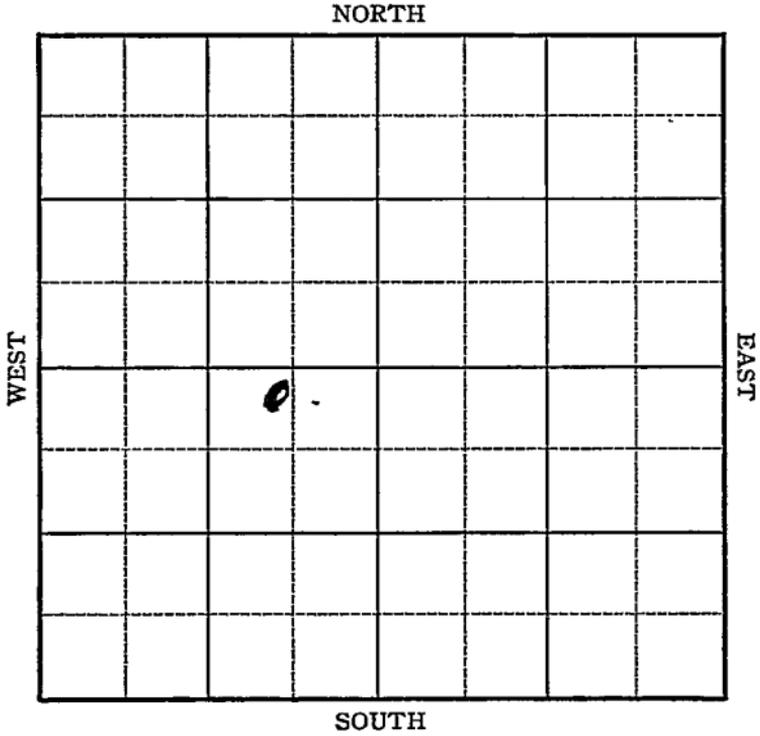

Sec. 31 Twp. 18 R. 7-W

Well No. #1 Bolton Farm
Sinclair-Prairie Company

Geneseo Pool


330 Ft. from N. Line

_____ Ft. from S. Line

790
~~778~~ Ft. from E. Line

_____ Ft. from W. Line

NW NE SW
Elev. 1738

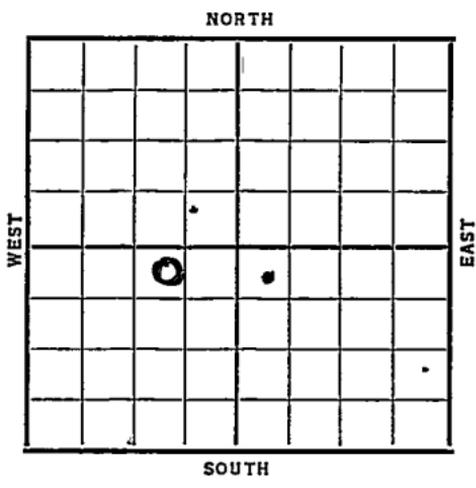

Date	REPORT
1937	
6/16	B. R.
6/25	R U R
7/2	"
7/9	"
7/16	12" @ 156'. WOG.
7/23	Drlg. 2285'.
7/30	Drlg. 3200'.
8/6	Sil. 3232 & 7". T.D. 3234'.
	Sat. core. RUST.
8/11	7" @ 3232'.
	Sil. 3232'.
	T.D. 3237'.
	1000 acid.
	Pot. 788 bbls.
	COMPLETED
	OVER

1954
4/27

OTD 3237'
Br lime 2768', KC 2806', Cong 3170'
Simp. sh 3177', Simp. Sd 3191', Arb.
3232'
TD 3235'
172/3195-3210',
B/11 go 11 gwph
Hydro. S/load
P/16 bo 4 bwph 4 hrs.
POP

5/5

5/12

Oil well TD 3237' OTD 3237
Br. lime 2768' KC 2806 Cong. 3170
Simp. sh. 3177 Simp. sd. 3191'
Arb. 3232' TD 3235 172/3195-3210
B/11 GO 11 GWPH Hydro. S/load
P/16 BO 4 BWPH 4 hr. P/227 BO
57 BW 24 hr. Comp. 270 BOPD 10% wtr.

COMPLETED

Rice KANSAS

Map No. 45 Sec. 31 Twp. 18 R. 7^w

Well No. 1 - Bolton

Simclair Prairie Company

Contractor

(They own all sw⁴ except east 31 A.)

FIRST RECORD


SECTION PLAT

330 Ft. from N. Line

_____ Ft. from S. Line

778 Ft. from E. Line

_____ Ft. from W. Line

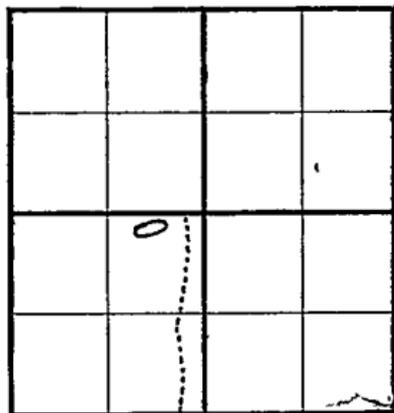

Location _____

Rig up _____

Drilling and Remarks:

B.R.

RECORD

Cased _____ in., _____ ft.

Sand _____

Gas _____

Oil _____

Total Depth _____

PRODUCTION

1st 24 hrs. Nat. _____

1st 24 hrs. after shot _____

Gas _____ Cu. Ft.

Dry Hole _____

Abandoned _____

Date

JUN 16 1937 19

H. D. Foster Scout

Rice KANSAS

Map No. 45 Sec. 31 Twp. 18 R. 7^WWell No. 1 - BoltonSinclair Prairie Company

Contractor

COMPLETED

SECTION PLAT

330 Ft. from N. Line

_____ Ft. from S. Line

778 Ft. from E. Line

_____ Ft. from W. Line

	0		

Location _____

Rig up _____

Drilling and Remarks:

1000 AcidLot - 788

RECORD

Cased 7 in., 3232 ft.Sand 511 3232

Gas _____

Oil _____

Total Depth 3237

PRODUCTION

1st 24 hrs. Nat. _____

1st 24 hrs. after shot _____

Gas _____ Cu. Ft.

Dry Hole _____

Abandoned _____

Date

AUG 11 1937

19

H. D. Hatfield

Scout

