


Section 31 Township 18 Range 7-W

Well No. #1 Bolton

Company Phillips

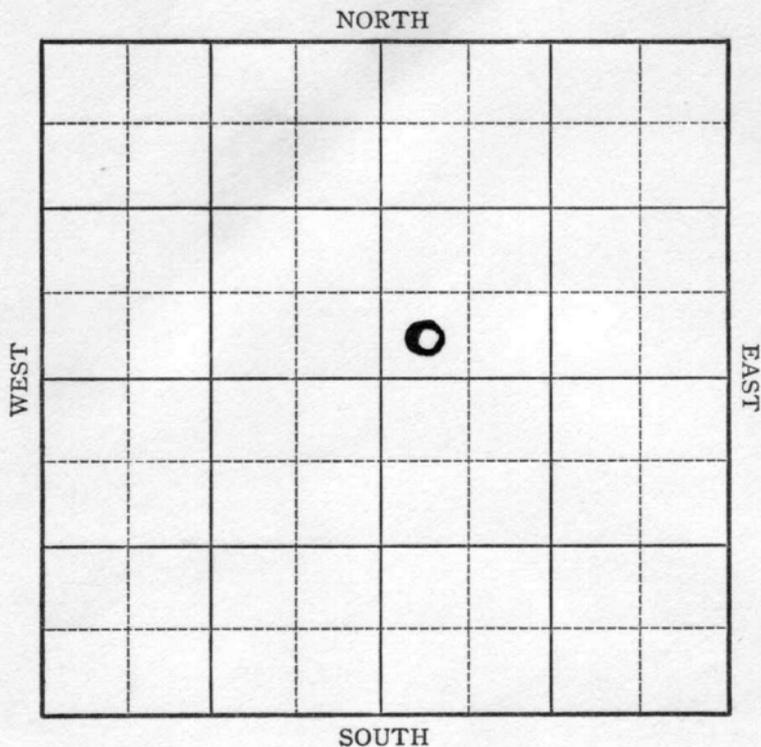

Sec. 31 Twp. 18 R. 7-W

Well No. #1 Bolton Farm
Phillips Company


 Ft. from N. Line

330 Ft. from S. Line

 Ft. from E. Line

276 Ft. from W. Line

Elev. 1703

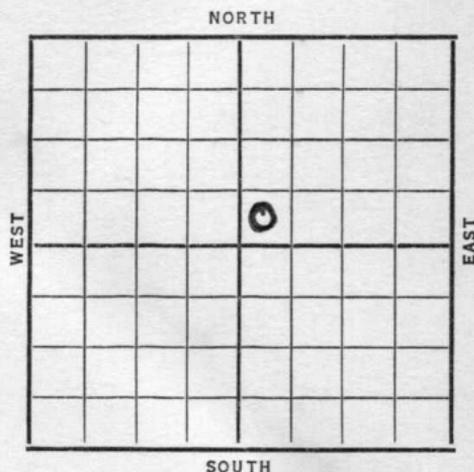

Date	REPORT
1937	
5/19	Cellar
5/28	S. H.
6/4	12" @ 231'. Drlg. 1530'.
6/11	Drlg. 2815'.
6/19	SDa3231'.
6/25	T.D. 3275'. S.W. SDO
7/2	" " " "
7/9	" " " "
7/16	" " " "
7/23	" " " "
7/28	Sil. 3223'.
	T.D. 3275'.
	ABANDONED

Rice KANSAS

Map No. 45 Sec. 31 Twp. 18 R. 7^w

Well No. 1-Bolton

Phillips Company

Contractor

FIRST REPORT

SECTION PLAT

		0	

_____ Ft. from N. Line

330 Ft. from S. Line

_____ Ft. from E. Line

276 Ft. from W. Line

Location _____

Rig up _____

Drilling and Remarks:

Cellar

RECORD

Cased _____ in., _____ ft.

Sand _____

Gas _____

Oil _____

Total Depth _____

PRODUCTION

1st 24 hrs. Nat. _____

1st 24 hrs. after shot _____

Gas _____ Cu. Ft.

Dry Hole _____

Abandoned _____

Date

MAY 19 1937 19

H. D. Hatfield

Scout

Rice KANSAS

Map No. 45 Sec. 31 Twp. 18 R. 7^w

Well No. 1 - Bolton

Phillips Company

Contractor

ABANDONED

SECTION PLAT

		0	

_____ Ft. from N. Line

330 Ft. from S. Line

_____ Ft. from E. Line

276 Ft. from W. Line

Location _____

Rig up _____

Drilling and Remarks:

D & A

RECORD

Cased _____ in., _____ ft.

Sand 511 3223

Gas _____

Oil _____

Total Depth 3275

PRODUCTION

1st 24 hrs. Nat. _____

1st 24 hrs. after shot _____

Gas _____ Cu. Ft.

Dry Hole _____

Abandoned _____

Date

JUL 28 1937

H. D. Hatfield Scout