



Sec. 5 Twp. 28 R. 7-E

Well No. #4 DeMoss "A" Farm \_\_\_\_\_

Rex & Morris Company \_\_\_\_\_


(Miscellaneous)

\_\_\_\_\_ Ft. from N. Line

330 Ft. from S. Line

990 Ft. from E. Line

\_\_\_\_\_ Ft. from W. Line

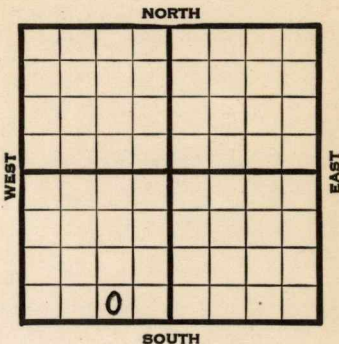

**Elev. 1411**

1939	REPORT
6/28	Machine. 15" - 88' 12" - 780'
	Drig. 1035.
7/6	10" - 1094' Drig. 1650'
7/13	<b>K. C. 2158' S.O. 2175-83'</b> Fsg. 2195'
7/20	8" - 2136' <b>Bart. 2660'</b>
	7" - 2646' T.D. 2689' WOC.
7/27	Swab 3 bbls. oil per hour.
8/3	Shot 20 qts. 2658-83' C.O.
8/10	Shut down.
8/16	<b>Bart. 2660'</b>
	7" - 2646'
	T.D. 2689'
	Shot 20 qts. 2658-83'
	35 bbls. oil.
	<b>COMPLETED</b>



Map No. 10 Sec. 5 Twp. 28 R. 7E

Well No. 4 DeMoss "A"

Rex & Morris Company

Contractor

COMPLETED

SW SE SW

         Ft. from N. Line

330 Ft. from S. Line

990 Ft. from E. Line

         Ft. from W. Line

SECTION PLAT


MISCELLANEOUS

Location                                 

Rig up                                 

Drilling and Remarks:

*Bar 7.2660*  
*7" @ 2646*  
*Shot 209 to 2658-83*  
*35 1/2*

RECORD

Cased          in.,          ft.

Sand                                 

Gas                                 

Oil                                 

Total Depth 2689

PRODUCTION

1st 24 hrs. Nat.                         

1st 24 hrs. after shot                         

Gas                                  Cu. Ft.

Dry Hole                                 

Abandoned                                 

Date

AUG 16 1939

19

S. J. LEWIS

Scout