


Cowley

KANSAS

SECTION 16 TOWNSHIP 34 RANGE 3 E

WELL NO. #3 Musson

COMPANY J. H. Wagner et al

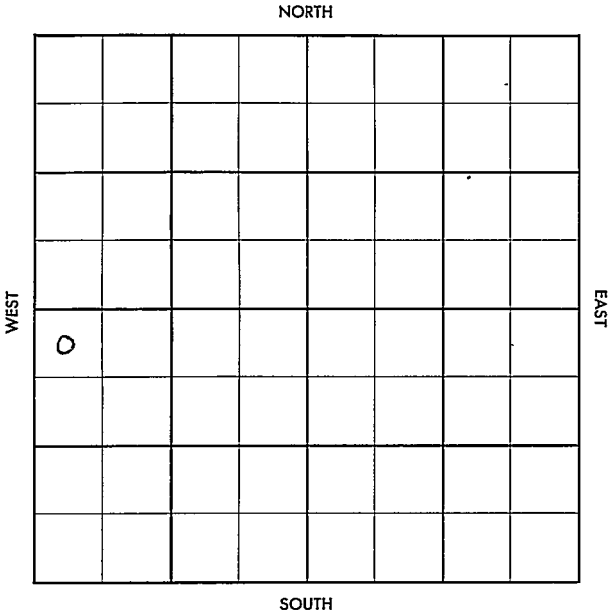

Cowley

KANSAS


SEC.	TWP.	R.
16	34	3E

WELL NO. #3 Musson FARM

COMPANY J.H. Wagner etal

CONTRACTOR Smitherman

Harvey
 _____ Ft. from N. Line
 _____ Ft. from S. Line
 _____ Ft. from E. Line
 _____ Ft. from W. Line

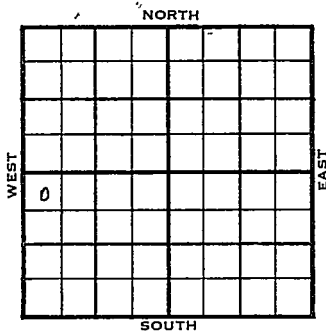

NW NW SW

1955	ELEVATION 1148'	REPORT
------	-----------------	--------

11-30 MIR

1956

1-5
 Comm. 11-21-55
 8 5/8 " @ 135/100
 5 1/2 " @ 3407/100
 CO to 3390, 40/ 3353-63, 10 bopd, 25 bw
 Comp. 15 bopd, 65 BW,
 Bart 3352
 M. 3396'
 TD 3407'

COMPLETED

County Cowley Elev. _____
 Sec. 16 Twp. 34 Rge. 3E
 Company J. H. Wagner et al.
 Farm Name Musson No. 3

TOPS	DEPTH	LOG	DATUM
Anh.			
TP.			
H.			
Tr.			
Dg.			
Bl.			
L.			
K.C.			
B.K.C.			
Ce.			
C.			
M.			
M.			
K.			
Mz.			
Mo.			
V.			
S.			
S.			
A.			
R.			
PE.			
G.			
T.D.			

Loc. in Sec. NW NW SW
 Geol. _____
 Contr. Smitherman
 Pool Harvey

FIRST REPORT	
0	NOV 30 '55

Date Comm. M I R

Co.
 Lse.
 No.
 Sec.
 T.
 R.

County Cowley Elev. 1148
 Sec. 16 Twp. 34 Rge. 3E
 Company J. H. Wagner etal.
 Farm Name Musson No. 3

TOPS	DEPTH	LOG	DATUM	Loc. in Sec.						
Anh.				NW NW SW						
Tr.	<u>3352</u>		<u>2204</u>							
M.	<u>3396</u>		<u>2248</u>							
T.D.	<u>3407</u>									
				Geol. _____						
				Contr. _____						
				Smitherman						
				Pool _____						
				Harvey						
				<table border="1"> <tr> <td colspan="2">COMPLETE</td> </tr> <tr> <td>0</td> <td></td> </tr> <tr> <td></td> <td></td> </tr> </table>	COMPLETE		0			
COMPLETE										
0										

Date Comm. 11-21-55 JAN 5 1956
8 5/8" @ 135/100 5 1/2" @ 3407/100
CO to 3390 40/ 3353-63 10 bopd
25 bw Comp. 15 bopd 65 bw

Co.
 No.
 Sec.
 T.
 R.