


KANSAS

Map No. _____ Sec. 16 Twp: 34 R. SE

Well No. 1 - Spruitt Farm _____

E. B. Shawder Company

NORTH

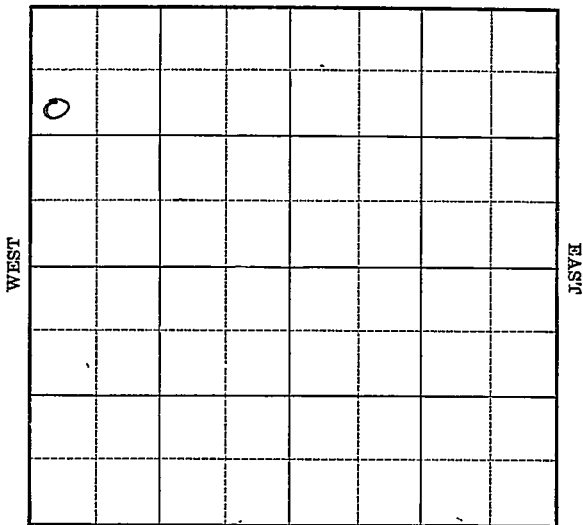

SOUTH

Location _____

Drilling Remarks _____

Rig Up _____

Drilling Remarks _____

RECORD

Cased _____ in. _____ ft.

Sand _____

Gas _____

Oil _____

Total Depth _____

PRODUCTION

1st 24 hrs. Nat. _____

1st 24 hrs. after shot _____


Gas _____ cu. ft.

Dry Hole _____

Abandoned _____

Map No. **KANSAS** Sec. 16 Twp. 34 R. 3E
 Well No. 1 - Schurtz Farm
E. B. Shawder Company

990 Ft. from N. Line
 _____ Ft. from S. Line
 _____ Ft. from E. Line
200 Ft. from W. Line

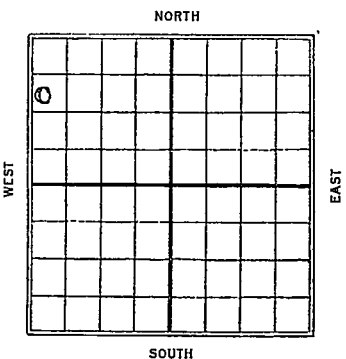

1928

Date	REPORT
6/13	Location
6/20	Timbers
6/27	—
7/3	Bldg rig
7/11	Rig
7/18	Spud
7/25	Drly 320.
8/1	" 1230
8/7	Sand 1887-95 - 4 ³ / ₄ M gas - S.D.
8/15	Drly 1985'
8/22	" 2327"
9/5	T.D. - 3010 - S.D.
9/12	1/2 M gas 3291-95
	oil 3295-3302
	No test
9/19	chat 3324-38
	72 bbl oil - Will shoot
9/26	running tubing
10/3	chat 3324'
	T.D. 3336'
	25 bbls oil pumped
	Comp

Map No. KANSAS Sec. 16 Twp. 34 R. 2E

Well No. 1 Schurtz

E. B. Schurter Company

Contractor

SECTION PLAT

0			

990 Ft. from N. Line

_____ Ft. from S. Line

_____ Ft. from E. Line

200 Ft. from W. Line

FIRST REPORTS

Location ✓

Rig up _____

Drilling and Remarks:

RECORD

Cased _____ in., _____ ft.

Sand _____

Gas _____

Oil _____

Total Depth _____

PRODUCTION

1st 24 hrs. Nat. _____

1st 24 hrs. after shot _____

Gas _____ Cu. Ft.

Dry Hole _____

Abandoned _____

Date

JUN 13 1928

S. J. LEWIS Scout

Cowley
MAP NO. **KANSAS** SEC. 16 TWP. 34 R. 27

WELL NO. 1 Schwartz

E. B. Shaver COMPANY

CONTRACTOR

SECTION PLAT

0			

990 FT. FROM N. LINE

_____ FT. FROM S. LINE

_____ FT. FROM E. LINE

200 FT. FROM W. LINE

COMPLETED

LOCATION _____

RIG UP _____

DRILLING AND REMARKS:

Chat 3324
TD 3336

25 ft. jumper

RECORD

CASED _____ IN., _____ FT.

SAND _____

GAS _____

OIL _____

TOTAL DEPTH _____

PRODUCTION

1ST 24 HRS. NAT. _____

1ST 24 HRS. AFTER SHOT _____

GAS _____ CU. FT.

DRY HOLE _____

ABANDONED _____

DATE

OCT 3 1928 192

S. J. LEWIS

SCOUT