

KANSAS


Butler

FORM 51 5M 10-41 PETROL

Section 5 Township 28 Range 7-E

Well No. #4 DeMoss "B"

Company Rex & Morris

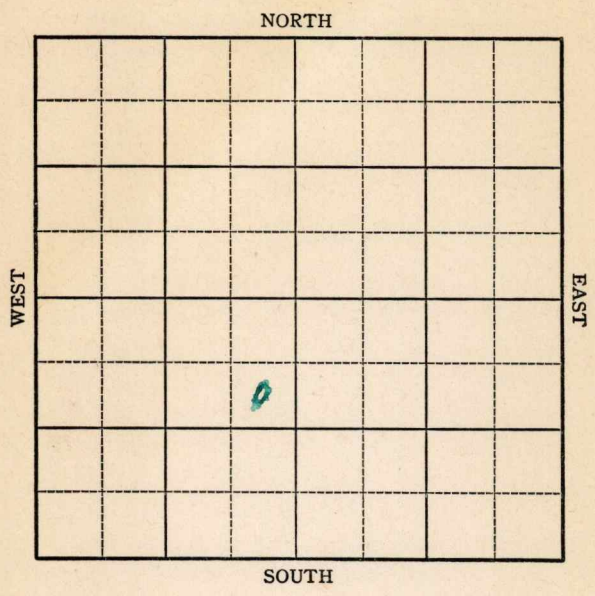

KANSAS

Butler

Sec. 5 Twp. 28 R. 7-E

Well No. #4 DeMoss "B" Farm

Rex & Morris Company

(Beaumont)


990 Ft. from N. Line

_____ Ft. from S. Line

330 Ft. from E. Line

_____ Ft. from W. Line

Elev. 1430

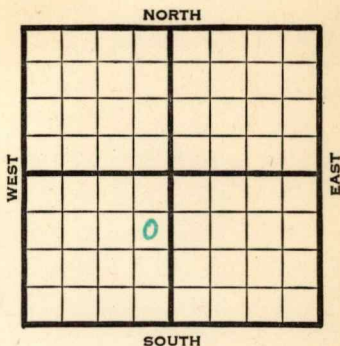

1941	REPORT
11/12	Location
11/20	Spud.
11/28	15" - 85' 12" - 805'
	Drlg. 1125'
12/4	10" - 1555' Drlg. 1875'
12/11	Bart 2700-23 TD 6" @ 2681 WOC
12/18	Barb 2675 (Corrected) TD 2723 CO
12/24	Shot 400 qts. C. O.
12/31	" " "
1942	
1/7	Bart. 2675' 6" - 2681' T.D. 2723' Shot 400 qts. Potential 25 bbls., pump. 38. Gravity.
	COMPLETED

Butler

KANSAS

Map No. K-10 Sec. 5 Twp. 28 R. 7E

Well No. 4 DeMoss "B"

Rex & Morris Company

FIRST REPORT Contractor

SE NE SW

SECTION PLAT

990 Ft. from N. Line

_____ Ft. from S. Line

330 Ft. from E. Line

_____ Ft. from W. Line

BEAUMONT POOL

Location XX

Rig up _____

Drilling and Remarks:

RECORD

Cased _____ in., _____ ft.

Sand _____

Gas _____

Oil _____

Total Depth _____

PRODUCTION

1st 24 hrs. Nat. _____

1st 24 hrs. after shot _____

Gas _____ Cu. Ft.

Dry Hole _____

Abandoned _____

Date

NOV 12 1941

S. J. LEWIS

Scout

Butler

Map No. 10 Sec. 5 Twp. 28 R. 7E

Well No. 4 DeMoss "B"

Rex & Morris Company

COMPLETED Contractor

SE NE SW

990 Ft. from N. Line

_____ Ft. from S. Line

330 Ft. from E. Line

_____ Ft. from W. Line

SECTION PLAT

BEAUMONT POOL

Location _____

Rig up _____

Drilling and Remarks:

Bar 2675
6" @ 2681
400 gts.
Pump 25 P.S.

380 ft

RECORD

Cased _____ in., _____ ft.

Sand _____

Gas _____

Oil _____

Total Depth 2723

PRODUCTION

1st 24 hrs. Nat. _____

1st 24 hrs. after shot _____

Gas _____ Cu. Ft.

Dry Hole _____

Abandoned _____

Date

JAN 7 1942 19

S. J. LEWIS

Scout