


Map No. **KANSAS** Sec. 5 Twp. 28 R. 7
Well No. 1 - Lemisch Farm
L. H. Davidson Company

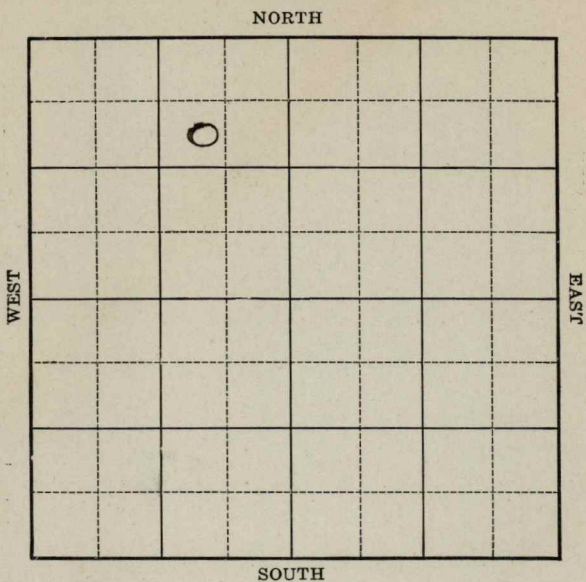

Location _____

Drilling Remarks _____

RECORD

Cased _____ in. _____ ft.

Sand _____

Gas _____

Oil _____

Total Depth _____

Rig Up _____

Drilling Remarks _____

PRODUCTION

1st 24 hrs. Nat. _____

1st 24 hrs. after shot _____

Gas _____ cu. ft.

Dry Hole _____

Abandoned _____

KANSAS

Map No. _____ Sec. 5 Twp. 28 R. 7

Well No. 1 - Semisich Farm

L. W. Davidson et al Company


_____ Ft. from N. Line

_____ Ft. from S. Line

_____ Ft. from E. Line

sub lot 3

_____ Ft. from W. Line

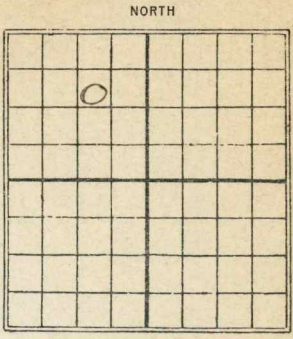

1928

Date	REPORT
<u>7/5</u>	<u>Location</u>
<u>7/13</u>	<u>_____</u>
<u>7/19</u>	<u>Timbers.</u>
<u>7/26</u>	<u>_____</u>
<u>8/2</u>	<u>Rig</u>
<u>8/9</u>	<u>_____</u>
<u>8/16</u>	<u>_____</u>
<u>8/23</u>	<u>_____</u>
<u>8/28</u>	<u>_____</u>
<u>9/4</u>	<u>_____</u>
<u>9/12</u>	<u>Spudding</u>
<u>9/19</u>	<u>_____</u>
<u>9/26</u>	<u>Drlg 640'</u>
<u>10/3</u>	<u>" 1325'</u>
<u>10/10</u>	<u>" 1700'</u>
<u>10/17</u>	<u>" 2050'</u>
<u>10/24</u>	<u>" 2382'</u>
<u>10/31</u>	<u>No sand</u>
	<u>T.D. 2800'</u>
	<u>Top line 2800</u>
	<u>dry & Abandoned</u>

Butler

K10 KANSAS

Map No. _____ Sec. 5 Twp. 28 R. 7

Well No. 1

Semisich Davidson et al

Company

Contractor

FIRST REPORTS

SECTION PLAT

_____ Ft. from N. Line

_____ Ft. from S. Line

_____ Ft. from E. Line

_____ Ft. from W. Line

	0		

SWc Lot 3.

Location _____ ✓

Rig up _____

Drilling and Remarks:

RECORD

Cased _____ in., _____ ft.

Sand _____

Gas _____

Oil _____

Total Depth _____

PRODUCTION

1st 24 hrs. Nat. _____

1st 24 hrs. after shot _____

Gas _____ Cu. Ft.

Dry Hole _____

Abandoned _____

Date

JUL 5 1928

CHAS. L. SHERWOOD

192

Scout

Butler

K 10 KANSAS

MAP No. _____ SEC. 5 TWP. 28 R. 7

WELL NO. P. 1 Semisch

L. D. Davidson et al COMPANY

CONTRACTOR

COMPLETED

SECTION PLAT

	0		

ABANDONED

_____ FT. FROM N. LINE
 _____ FT. FROM S. LINE
 _____ FT. FROM E. LINE
 _____ FT. FROM W. LINE

SW/4 Lot 3

LOCATION _____

RIG UP _____

DRILLING AND REMARKS:

No sand
 Top line
 2800

RECORD

CASED _____ IN., _____ FT.
 SAND _____
 GAS _____
 OIL _____
 TOTAL DEPTH _____ 2800

PRODUCTION

1ST 24 HRS. NAT. _____
 1ST 24 HRS. AFTER SHOT _____
 GAS _____ CU. FT.
 DRY HOLE
 ABANDONED

DATE

OCT 31 1928

CHAS. L. SHERWOOD

192

SCOUT