

KANSAS

Form 51-5M-7-39-Palace


Rice

Section 30 Township 18 Range 7-W

Well No. #3 C. W. Poland

Company Continental

NORTH Geneseo Pool

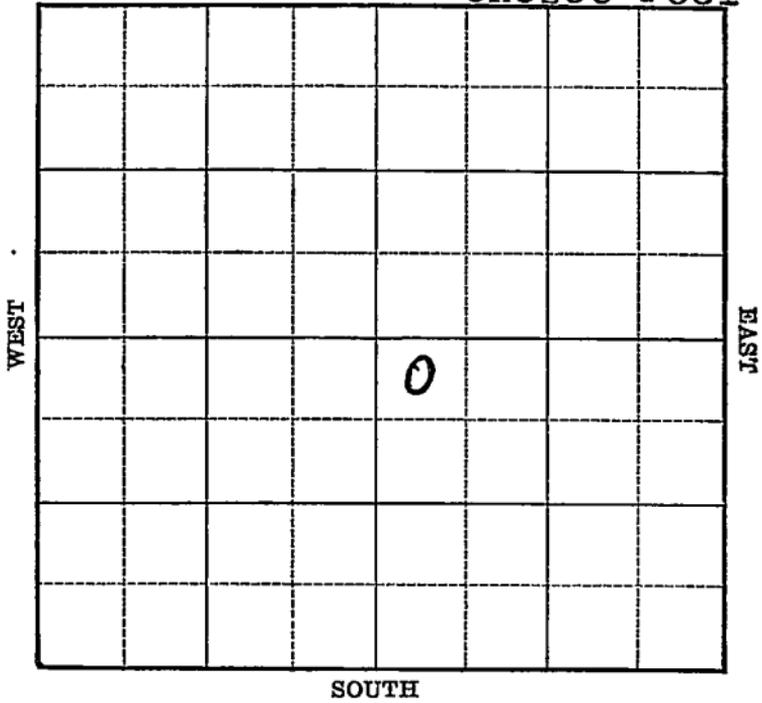

1940
1/3

Arb. 3145'

7" - 3146'

T.D. 3189'

P.B. to 3153'

2000 acid.

Potential 170 bbl s., pump.

COMPLETED

Map No. 45 Sec. 30 Twp. 18 R. 7WWell No. 3 C. W..PolandContinental

Company

Contractor

FIRST REPORT

SECTION PLAT

NW SE

330 Ft. from N. Line

_____ Ft. from S. Line

_____ Ft. from E. Line

330 Ft. from W. Line

		o	

GENESEO POOL

Location _____

Rig up _____

Drilling and Remarks:

11" - 213
WOC

RECORD

Cased _____ in., _____ ft.

Sand _____

Gas _____

Oil _____

Total Depth _____

PRODUCTION

1st 24 hrs. Nat. _____

1st 24 hrs. after shot _____

Gas _____ Cu. Ft.

Dry Hole _____

Abandoned _____

Date

OCT 11 1939

19

S. J. LEWIS Scout

