


Section 5 Township 14 Range 17W

Well No. 1 George

Company Sunray Oil

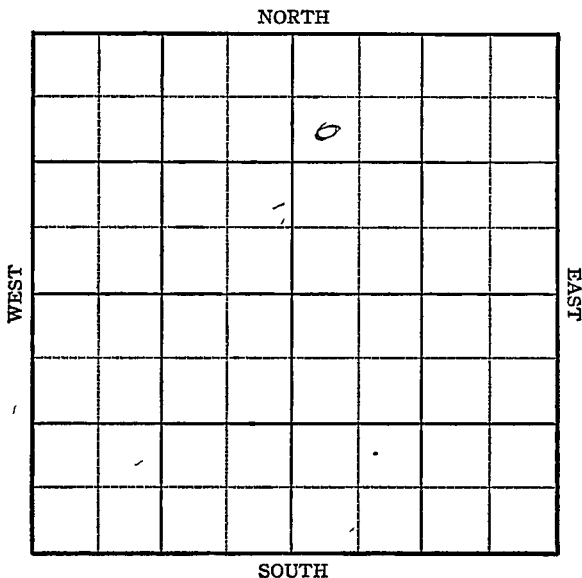

Sec. 5 Twp. 14 R. 17-W

Well No. #1 George Farm


Sunray Oil Company

990 Ft. from N. Line

\_\_\_\_\_ Ft. from S. Line

\_\_\_\_\_ Ft. from E. Line

330 Ft. from W. Line

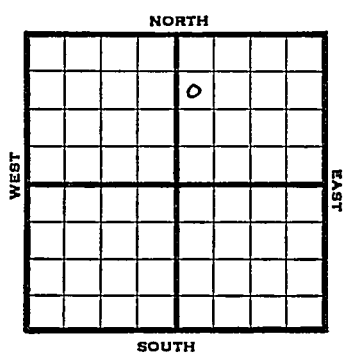

SW NW NE

1945

Elev. - 2028 REPORT

10/3 Anhy. 1225  
8" @ 1235'  
Drlg. 2340'

10/10 Drlg. 3335

10/17 Heebner 3262  
Lans. 3305  
Arb. 3838  
TD 3850 500 acid.  
Swab 5 oil per hr.

10/24 " " "  
10/31 " " "  
11/7 Arb. 3538  
5" @ 3539  
500 acid.  
TD 3550  
Pump 408 Pot.  
Grag. 34.0

COMPLETED

KANSAS Kansas

Pool Name Younger

Map No. 71 Sec. 5 Twp. 14 R. 17W

Well No. 1 George

Sunray Oil

Company

## FIRST REPORT

Contractor

SW NW NE

## SECTION PLAT

990 Ft. from N. Line

Ft. from S. Line

Ft. from E. Line

330 Ft. from W. Line

		o	

Ellis County

Location

Rig up

Drilling and Remarks:

any 1225

8"-1235

2340

## RECORD

Cased \_\_\_\_\_ in., \_\_\_\_\_ ft.

Sand \_\_\_\_\_

Gas \_\_\_\_\_

Oil \_\_\_\_\_

Total Depth \_\_\_\_\_

## PRODUCTION

1st 24 hrs. Nat. \_\_\_\_\_

1st 24 hrs. after shot \_\_\_\_\_

Gas \_\_\_\_\_ Cu. Ft.

Dry Hole \_\_\_\_\_

Abandoned \_\_\_\_\_

Date

OCT 3 1945 19

S. J. LEWIS Scout

Pool Name Younger

KANSAS Kansas

Map No. 71 Sec. 5 Twp. 14 R. 17W

Well No. 1 Geor e

Sunray Oil Company

**COMPLETED**

Contractor

SW NW NE

*F12028*

SECTION PLAT

990 Ft. from N. Line

\_\_\_\_\_ Ft. from S. Line

\_\_\_\_\_ Ft. from E. Line

330 Ft. from W. Line

		0	

Ellis County

Location \_\_\_\_\_

Rig up \_\_\_\_\_

Drilling and Remarks:

*Core 3538  
5" @ 3539  
500 rods  
Pump 405 ft  
342 Gr*

**RECORD**

Cased \_\_\_\_\_ in., \_\_\_\_\_ ft.

Sand \_\_\_\_\_

Gas \_\_\_\_\_

Oil \_\_\_\_\_

Total Depth 3550

**PRODUCTION**

1st 24 hrs. Nat. \_\_\_\_\_

1st 24 hrs. after shot \_\_\_\_\_

Gas \_\_\_\_\_ Cu. Ft.

Dry Hole \_\_\_\_\_

Abandoned \_\_\_\_\_

Date

NOV 7 1945 19

S. J. LEWIS Scout