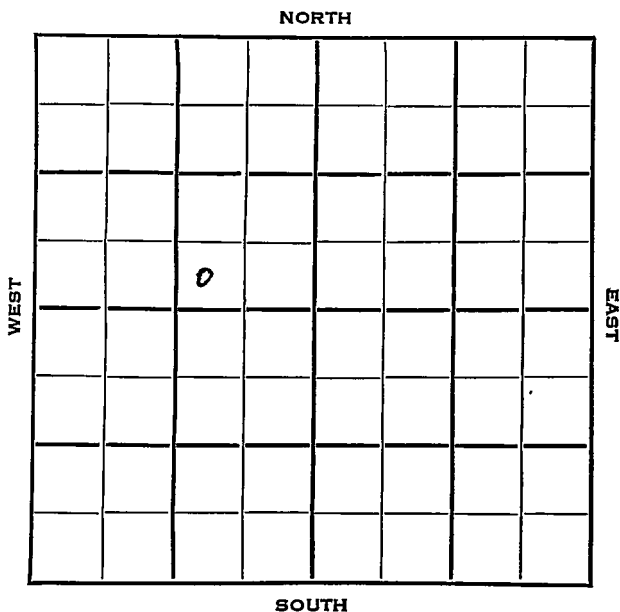


Section 5 Township 14 Range 17WWell No. #1 PfeiferCompany Frontier Oil

Ellis

KANSAS

SEC.	TWP.	R.
5	14	17 W ✓

WELL NO.

1 Pfeifer

FARM

COMPANY

Frontier Oil

CONTRACTOR

Shafer Drlg.

Younger Pool

Ft. from N. Line

330


Ft. from S. Line

990

Ft. from E. Line

Ft. from W. Line

SW SE NW

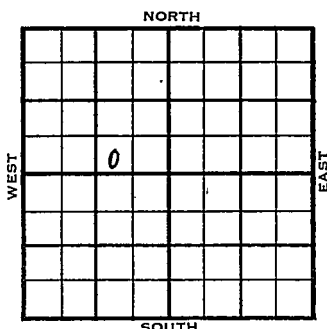

Sunray Farmout

	ELEVATION	REPORT
1954	2022'	

3/17

Spud 3-10-54

8" @ 183

Drlg. 3040'

3/24

Heeb 3256 Lans 3295 Arb. 3535
RTD 3539 5" @ 3537

3/31

DD 3547 1000 A S/5 BOPH
Channeld sq.

4/7

CO 3540 S/5 BOPH 6 hrs. POP

5/5

Spud 3-10-54

Oil Well

TD 3547'

8" @ 183'

Heeb 3256', Lans 3295', Arb 3535'

TD 3539'

5" @ 3537'

DD 3547'

1000 A S/ 5 boph CO to 3547'

S/ 5 boph 6 hr.

Comp 60 bopd.

COMPLETED

County **Ellis** State **Kansas**

Sec. 5 (Blk. Twp.) 14 (Sur. Rge.) 17W Map No.

Operator **Frontier Oil**

Well No. **1** Farm **Pfeifer**

Elev.	2022	Location	SW	SE	NW
-------	------	----------	----	----	----

0

FIRST REPORT

330 Ft. From S Line NW

990 Ft. From E Line Quarter

1st. Report **MAR 17 1954**

Completion


Remarks Sunray farmout

Shafer Drlg. - Contr.

Spudding Date **3-10-54**

Drlg. Data Younger Pool

8" @ 183 drlg. 3040

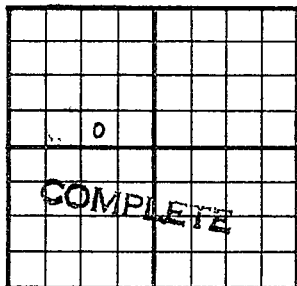County Ellis State KansasSec. 5 (Blk.) 14 (Sur.) 17W Map No.Operator Frontier OilWell No. 1 Farm PfeiferElev. 2022 Location SW SE NW330 Ft. From S Line NW990 Ft. From E Line Quarter

1st. Report

Completion MAY 5 1954.Remarks Younger PoolSchafer Drlg. - Contr.Spudding Date 3-10-54Drlg. Data Oil well TD 35478" @ 183 Heeb. 3256 Lans. 3295Arb. 3535 TD 3539 5" @ 3537DD 3547 1000 A S/ 5 boph CO to 3547S/ 5 boph 6 hr. Comp. 60 bopd

J. G. McGEHEE