


KANSAS Ellis County

FORM 51 5M PETROL

Section 5 Township 14 Range 17W

Well No. 1 Pfeifer "B"

Company Sunray

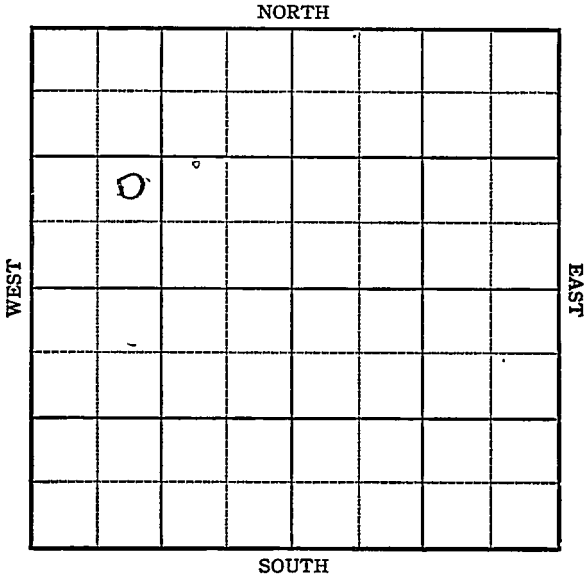

KANSAS

Ellis

Sec. 5 Twp. 14 R. 17W

Well No. 1 Pfeifer "B" Farm
Sunray Company


Younger

_____ Ft. from N. Line

990 Ft. from S. Line

_____ Ft. from E. Line

990 Ft. from W. Line

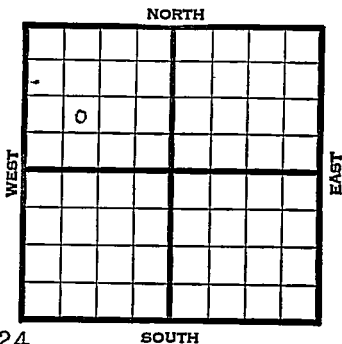

NE SW NW Elev. 2024

SOUTH

1945

REPORT

5/16	RUR
5/24	"
5/31	10" @ 197
6/8	Drig. 3195'
	Heebner 3262 Lans 3200, Cong.
	3541 Arb. 3550-53 TD 5" @
	3551 RUST
6/14	TD 3603
	500 acid
	Est 60 oil a day
6/21	" " " "
6/28	" " " "
7/21	Arb. 3550
	5" @ 3551
	500 acid.
	TD 3603'
	Pump 186 Pot.
	Grav. 33.0

COMPLETED

Kansas Pool Name YoungerMap No. 71 Sec. 5 Twp. 14 R. 17WWell No. 1 Pfeifer "B"Sunray

Company

FIRST REPORT

Contractor

NE SW NW

SECTION PLAT

_____ Ft. from N. Line

990

_____ Ft. from S. Line.

_____ Ft. from E. Line

990

_____ Ft. from W. Line

	o		

Ellis

Location _____

Rig up _____

Drilling and Remarks:

RUR

RECORD

Cased _____ in., _____ ft.

Sand _____

Gas _____

Oil _____

Total Depth _____

PRODUCTION

1st 24 hrs. Nat. _____

1st 24 hrs. after shot: _____

Gas _____ Cu. Ft.

Dry Hole _____

Abandoned _____

Date

MAY 1 6 1945 19S. J. LEWIS Scout

KANSAS Kansas Pool Name Younger

Map No. 71 Sec. 5 Twp. 14 R. 17W

Well No. 1 Pfeifer "B"

Sunray Company

COMPLETED

Contractor

NE SW NW

E12084
SECTION PLAT

_____ Ft. from N. Line

990 Ft. from S. Line

_____ Ft. from E. Line

990 Ft. from W. Line

o			

Ellis County

Location _____

Rig up _____

Drilling and Remarks:

Cor 4350
510 3551
500 acid
Pump 156 ft

33 e.g.

RECORD

Cased _____ in., _____ ft.

Sand _____

Gas _____

Oil _____

Total Depth 3603

PRODUCTION

1st 24 hrs. Nat. _____

1st 24 hrs. after shot _____

Gas _____ Cu. Ft.

Dry Hole _____

Abandoned _____

Date

JUL 11 1945 19

S. J. LEWIS Scout