



Map No. .... Sec. .... Twp. .... R. ....

Well No. .... Farm


..... Company

..... Ft. from N. Line

..... Ft. from S. Line

..... Ft. from E. Line

..... Ft. from W. Line

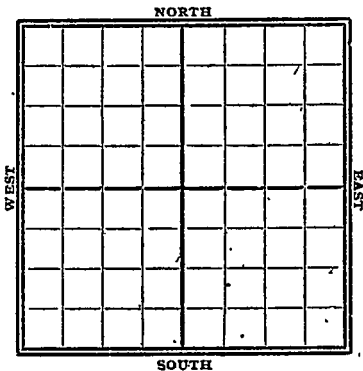

1917

Date

REPORT

*Gypsy Records*

5/30

*Abd T.D. 1450'*

*Part 111*  
 K14 MAP NO. KANSAS SEC. 25 TWP. 75S R. 1E

WELL NO. 2 Bonnie  
Snclair COMPANY

CONTRACTOR

ABANDONED

SECTION PLAT

	0		

\_\_\_\_\_ FT. FROM N. LINE  
 \_\_\_\_\_ FT. FROM S. LINE  
 \_\_\_\_\_ FT. FROM E. LINE  
 \_\_\_\_\_ FT. FROM W. LINE

RECORD

LOCATION \_\_\_\_\_  
 RIG UP \_\_\_\_\_  
 DRILLING AND REMARKS:

CASED \_\_\_\_\_ IN. \_\_\_\_\_ FT.  
 SAND \_\_\_\_\_  
 GAS \_\_\_\_\_  
 OIL \_\_\_\_\_  
 TOTAL DEPTH 1450

PRODUCTION

1ST 24 HRS. NAT. \_\_\_\_\_  
 1ST 24 HRS. AFTER SHOT \_\_\_\_\_  
 GAS \_\_\_\_\_ CU. FT.  
 DRY HOLE ✓  
 ABANDONED ✓

DATE

5/30 1917 \_\_\_\_\_ SCOUT