

# O. W. D. D

FORM 51


Rice

KANSAS

Section 31 Township 18 Range 7W

Well No. #2  
#1 Bolton

Company G-M-R.  
Chester Williams

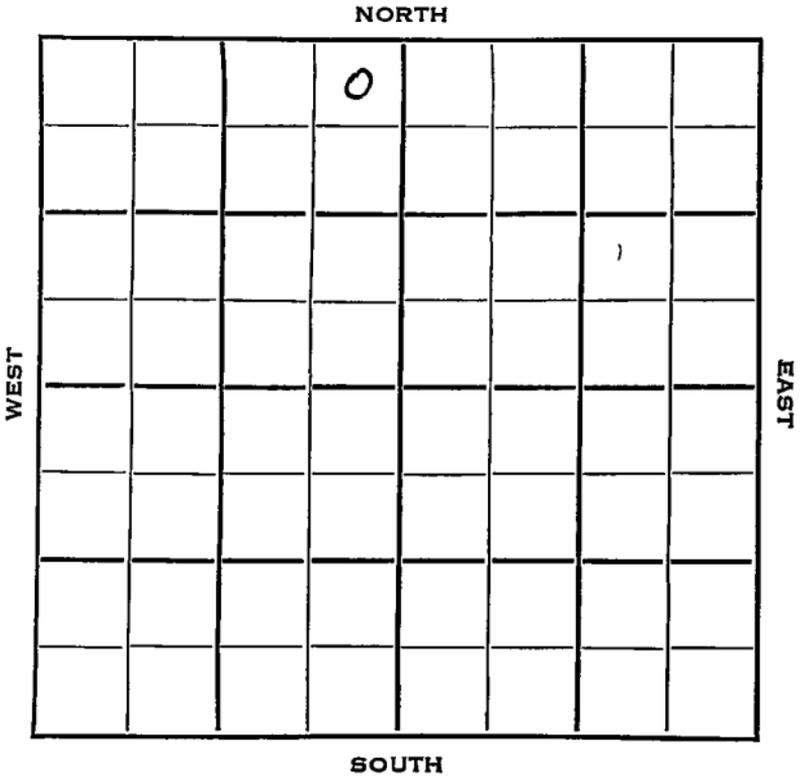

Sec. 31 Twp. 18 R. 7W

Well No. ~~#1~~ <sup>#2</sup> Bolton Farm

~~G-M-R.~~  
~~Chester Williams~~ Company

Shelly-Miller Contractor  
Geneseo Pool


330 Ft. from N. Line

Ft. from S. Line

330 Ft. from E. Line

Ft. from W. Line

NE NE NW (TWIN WELL)

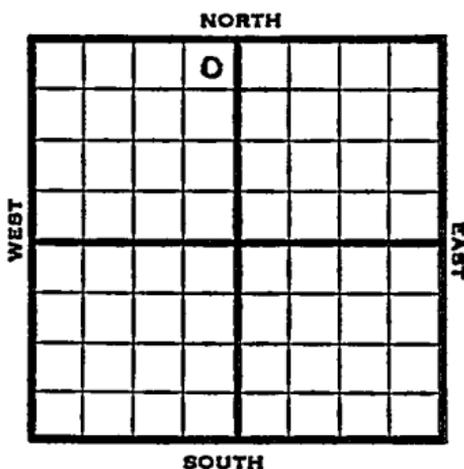

1953

Elev. 1702'

REPORT

4/22

Spud 4-18-53  
8" @ 202  
Drlg. 1430'

4/30

Drlg. 3230'

5/6

Spud 4-18-53  
D&A  
TD 3186  
8" @ 202  
Br lime 2725', Lans 2758', B KC 3072,  
Cong 3124, Simp 3156  
TD 3186  
D&A

**ABANDONED**

1955  
11/2

**O. W. D. D**

OTD 3186'. DD 3188'  
4 1/2" @ 3188/150'  
Old tops: Lans. 2758', Cong 3124',  
Simp. 3156'

12-7

3 bw 1 hr.,  
S/ 2 bwph frac  
P/ 6 1/2 bfph, 90% wtr.,  
P/ 54 bo, 52% wtr., 24 hrs,  
Comp. 54 bopd, 52% wtr.  
L. 2758 S. 3156  
C. 3124 TD 3186'

**COMPLETED**

County Rice State Kansas

Sec. 31 (Blk. Twp.) 18 (Sur. Rge.) 7W Map No.

Operator Chester Williams

Well No. 1 Farm Bolton

Elev. Location NE NE NW (twin well)

			o		

330 Ft. From N Line NW

330 Ft. From E Line Quarter

lst. Report APR 22 1953

Completion \_\_\_\_\_

Remarks \_\_\_\_\_

Shelly-Miller - Contr.

Spudding Date 4-18-53

Drlg. Data Geneseo Pool

8" @ 202 drlg. 1430





OWDD

County Price Elev. 1702  
 Sec. 37 Twp. 18 Rge. 7W  
 Company G-M-R (Williams)  
 Farm Name Bolton (was #1) No. 2

TOPS	DEPTH	LOG	DATUM
Anh.			
Tp.			
H.			
Tr.			
Dg.			
Bl.			
L.	<u>2758</u>		<u>10.56</u>
K.C.			
B.K.C.			
Ce.			
C.	<u>3124</u>		<u>1422</u>
M.			
M.			
K.			
Mz.			
Ma.			
V.			
S.	<u>3156</u>		<u>1454</u>
S.			
A.			
R.			
PE.			
G.			
T.D.	<u>3186</u>		

Loc. in Sec. NE, NE NW  
twin  
 Geol. \_\_\_\_\_  
 Contr. \_\_\_\_\_  
 Pool Geneseo

0		
COMPLETED		

Date Comm. DEC 7 1955  
OTD 3186 DD 3188 4 1/2" @ 3188/150  
3 bw 1 hr. S/ 2 bwph frac  
P/ 6 1/2 bfph 90% wtr. P/ 5 1/4 w  
52% wtr. 24 hr. Comp. 5 1/4 bopd 52% wtr.

Co. Lse. No. Sec. T. R.