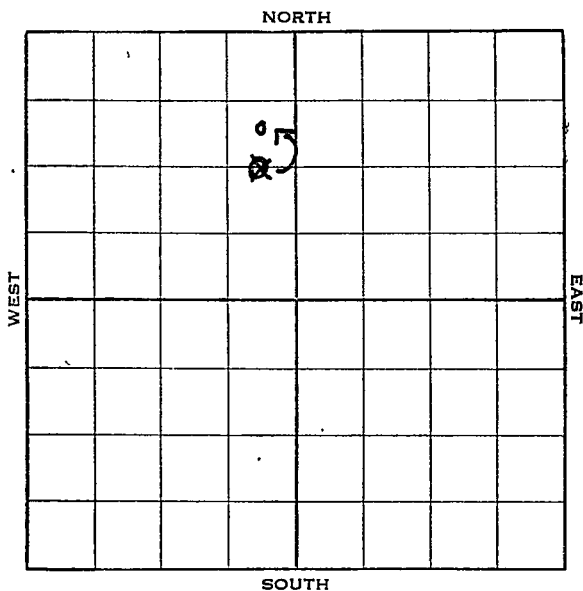


O.W.W.O.

Rice

KANSAS

Section 31 Township 18 Range 7-WWell No. 2 BoltonCompany G-M-R
~~Continental~~

Sec. 31 Twp. 18 R. 7-WWell No. #2 Bolton FarmG-M-RContinental

Company

920 L+J- CONTR
1320 GENESSEE POOL

Ft. from N. Line

Ft. from S. Line


330

Ft. from E. Line

Ft. from W. Line

SE NE NW

Elev. 1717

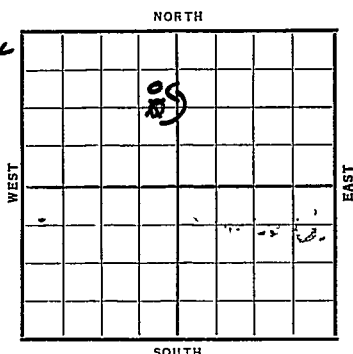

Date

REPORT

1938

3/9

Location

3/18

10" @ 205'. K.C. 2790'.

Arb. 3212'. 7" @ 3213'. S.O.

RUST.

3/25

T.D. 3216'. 3025' oil.

3/30

7" @ 3213'.

Arb. 3212'.

T.D. 3216'.

1000 acid.

Potential 1994 bbls.

COMPLETED

1954

7/14

O.W.W.O.
 Top 2340', KC 2790', B-KC 3145',
 Cong 3145', Simp 3155', Arb. 3212'
 OFD 3216'

7" @ 3213'

CO 4½" @ 3202'

To CO & Perforate

OVER

1954

10/6

Oil Well

TD 3216'

Top. 2340'; KC 2790', B KC 3145',

Cong 3145', Simp 3155', Arb 3212'

OTD 3216'

7" @ 3213'

4½" @ 3202'

CO to 3200'

72/ 3160-68 1/ 3162- 1/ 3164

frac. S/ 5 boph dec. to 4 boph

P/ 15 bo 5 bw 10 hrs.

Comp 34 bopd. 31%

COMPLETED


Rice

KANSAS

Map No. 45 Sec. 31 Twp. 18 R. 7WWell No. 2 BoltonContinental Company Contractor

FIRST REPORT

SECTION PLAT

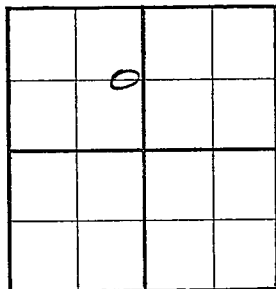C E L NW $\frac{1}{4}$ 1320 Ft. from N. Line Ft. from S. Line330 Ft. from E. Line Ft. from W. LineLocation XRig up

Drilling and Remarks:

RECORD

Cased in., ft.Sand Gas Oil Total Depth

PRODUCTION

1st 24 hrs. Nat. 1st 24 hrs. after shot Gas Cu. Ft.Dry Hole Abandoned

Date

MAR 9 - 1938

19

H. D. Hatfield Scout

Rice KANSAS

Map No. 45 Sec. 31 Twp. 18 R. 7WWell No. 2 BoltonContinental

Company

Contractor

COMPLETED

C E L NW

SECTION PLAT

	0		

1320 Ft. from N. Line

_____ Ft. from S. Line

330 Ft. from E. Line

_____ Ft. from W. Line

RECORD

Location _____

Cased 7 in., 3213 ft.

Rig up _____

Sand Arb 3212

Drilling and Remarks:

Gas _____

1000 and

Oil _____

Total Depth 3216POT 1994

PRODUCTION

1st 24 hrs. Nat. _____

1st 24 hrs. after shot _____

Gas _____ Cu. Ft.

Dry Hole _____

Abandoned _____

Date

MAR 30 1938 19

H. D. Hatfield Scout

FIRST REPORT

Spudding Date , ,


to CO & perforate

7th @ 3213 CO 4^{1st} @ 3202
rforate

Correct ft
+ spot

J. G. McGEHEE

County Rice State Kansas
 Sec. 31 (Blk. 18 (Sur. 7W Map No.)
 (Twp.) (Rge.)
 Operator G-M-R (was Continental)
 Well No. 2 Farm Bolton
 Elev. 1717 Location SE NE NW

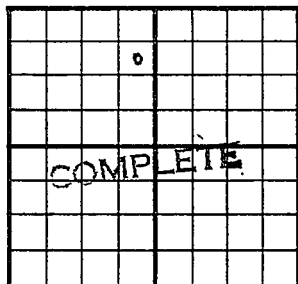

990 Ft. From N Line NW
330 Ft. From E Line Quarter
 Ist. Report
 Completion OCT 6 1954
 Remarks Geneseo Pool
L & J - Contr.
 Spudding Date

Drlg. Data Oil well TD 3216
Top. 2340 KC 2790 B KC 3145
Cong. 3145 Simp. 3155 Arb. 3212
OTD 3216 7" @ 3213. 4 $\frac{1}{2}$ " @ 3202
CO to 3200 72/ 3160-68 1/ 3162
1/ 3164 frac S/ 5 boph dec. to 4 boph
P/ 15 bo 5 bw 10 hr. Comp. 34 bopd 31%

FABEN GILSTRAP