


Section 5 Township 14 Range 17W

Well No. 2 George

Company Sunray Oil

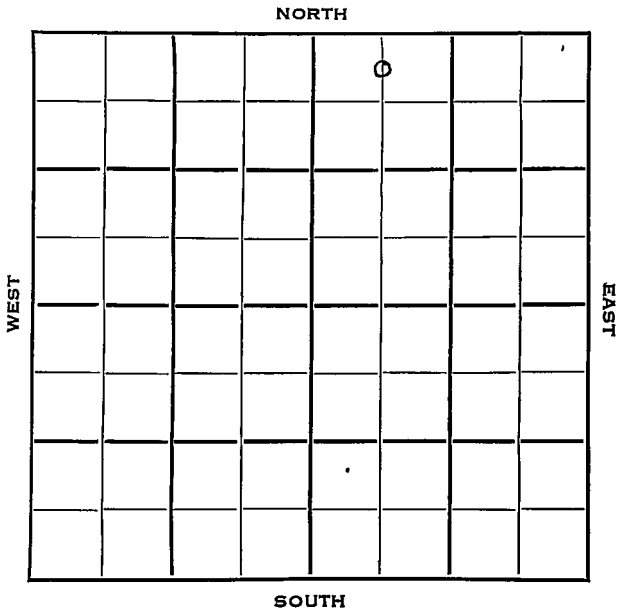

Ellis

KANSAS ✓

Sec. 5 Twp. 14 R. 17W

Well No. 2 George Farm

Sunray Oil Company

Contractor


330 Ft. from N. Line

Ft. from S. Line

Ft. from E. Line

660 Ft. from W. Line

G N $\frac{1}{2}$ NW NE

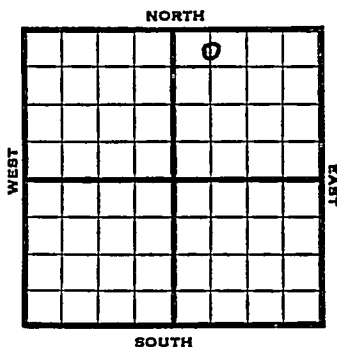

1953 Elev. 2029' REPORT

- 4/1 Spud 3-28-53
Anhy 1220
Drlg 1230
- 4/9 8" @ 1229
Heeb 3261, Lans 3305
Drlg 3340'
- 4/16 DST 3322-40, 1 hr., 125' O&GCM, 490#
DST 3378-97 1 hr., 45' wtr., 1060#
Arb 3555 Schl
RTD 3560
5" @ 3556, CO
- 4/23 DD 3595 TD A-frac - POP
- 4/30 NR
- 5/7 NR
- 5/20 Spud 3-28-53
Oil Well
TD 3595
Anhy 1220
8" @ 1229
Heeb 3261, Lans 3305
DST 3322-40, opn 1 hr., rec. 125' o&gcm
490#
DST 3378-97, opn 1 hr., rec. 45' wtr
1060#
Arb 3555
TD 3560
5" @ 3556, DD 3595, A-frac
Comp 2 bopd

COMPLETED

County Ellis State Kansas

Sec. 5 (Blk. 14 (Sur. 17W Map No. 17W)
(Twp.) (Rge.)

Operator Sunray Oil

Well No. 2 Farm George

Elev. 2029 Location C N $\frac{1}{2}$ NW NE

			o		

330 Ft. From N Line NE

660 Ft. From W Line Quarter

Ist. Report

Completion MAY 20 1953

Remarks

Spudding Date 3-28-53

Drlg. Data Oil well TD 3595

Anhy 1220 8" @ 1229 Heeb. 3261

Lans. 3305 DST 3322-40 open 1 hr.

Rec. 125' o & gcm 490# DST 3378-97

open 1 hr. Rec. 45' wtr. 1060#

Arb. 3555 TD 3560 5" @ 3556 DD 3595

A-frac Comp. 2 bopd