

Well No. 1- Hop Kins Farm
Jennings Tur Wells Company
 NORTH

NORTH

[illegible]

SOUTH

Drilling Remarks

Drilling Remarks

RECORD

Sand_____

Gas.....

Oil.....

Total Depth.....

PRODUCTION,

1st 24 hrs. Nat.....

1st 24 hrs. after shot.....

Gas.....cu. ft.....

Dry Hole.....

Abandoned.....

Map No. Sec. Twp. R.

Well No. Farm


..... Company

..... Ft. from N. Line

..... Ft. from S. Line

..... Ft. from E. Line

..... Ft. from W. Line

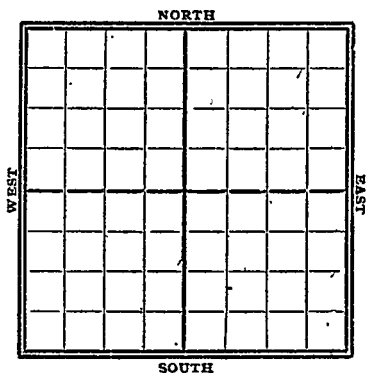

1918

Date

REPORT

Gypsy Records

9/4

Abd T.D. 2705

Butler
K14 MAP NO. KANSAS SEC. 23 TWP. 25S R. 1E

WELL NO. 1 Hopkins
Jennings & Son Wells COMPANY

CONTRACTOR

SECTION PLAT

ABANDONED

_____ FT. FROM N. LINE

_____ FT. FROM S. LINE

_____ FT. FROM E. LINE

_____ FT. FROM W. LINE

LOCATION _____

RIG UP _____

DRILLING AND REMARKS:

RECORD

CASED _____ IN. _____ FT.

SAND _____

GAS _____

OIL _____

TOTAL DEPTH 2705

PRODUCTION

1ST 24 HRS. NAT. _____

1ST 24 HRS. AFTER SHOT _____

GAS _____ CU. FT.

DRY HOLE ☒

ABANDONED ☒

DATE

9/14 19218 _____ SCOUT