


Section 5 Township 14 Range 17W

Well No. 2 Pfeifer "C"

Company Sunray

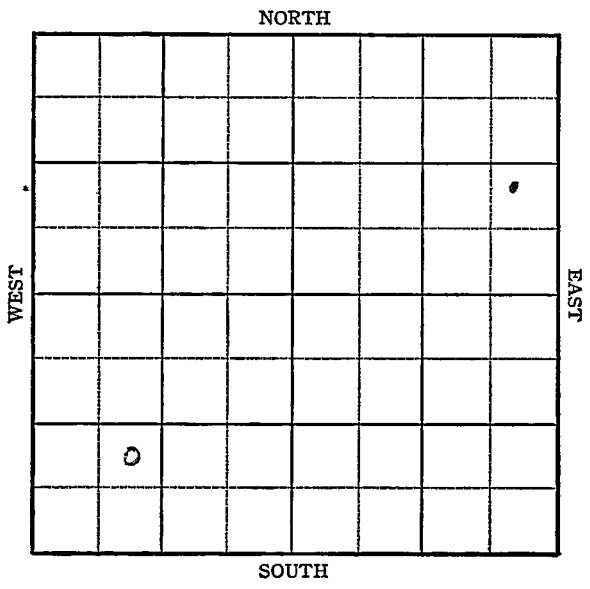

KANSAS Ellis

Sec. 5 Twp. 14 R. 17-W

Well No. #2 Pfeifer "C" Farm _____


Sunray Company _____

_____ Ft. from N. Line

990 Ft. from S. Line

_____ Ft. from E. Line

990 Ft. from W. Line

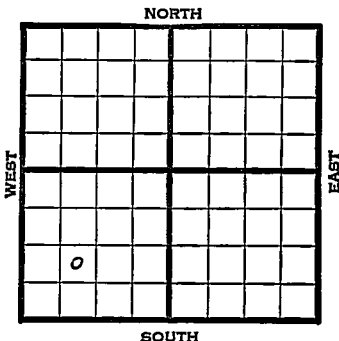

NE SW SW Elev. 2019

1945

REPORT

- 8/22 RUR
- 8/29 8" @ 1220
Drlg. 1995
- 9/5 Drlg. 3500'
- 9/12 Lens 3297
Cong 3541
Arb. 3547-3551
TD 3551
5" @ 3548' RUST
- 9/19 3595 1500 acid.
Swab 1/2 oil per hr. 8 hrs.
.3620 to acidize
- 9/26 No report
- 10/3 800 acid.
TD 3640 HFW
PB 3425
36 shots 3380-3404 1000 acid.
- 10/10 Arb. 3547
5" @ 3548
TD 3640'

ABANDONED

35-42
2019
1528

