

Butler


Section 7 Township 28 Range 7-EWell No. 2 SutterCompany Murfin et al

Beaumont pool

NORTH

WEST

EAST

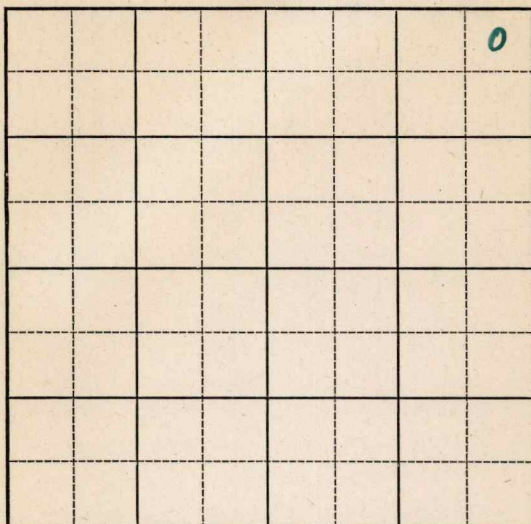

SOUTH

1941	REPORT
8/20	Cable.
8/28	"
9/4	"
9/11	"
9/18	Rigging up.
9/25	Shut down.
10/2	" "
10/9	" "
10/16	" "
10/23	" "
10/30	" "
11/6	" "
11/13	" "
11/20	15" - 125' Drlg. 750'
11/28	12" - 830' Drlg. 1220'
12/4	10" - 1537' Drlg. 1920'
12/11	Miss 2709 Drlg. 2710
	OVER

1941

12/17

Miss 2709

Water

TD 2721

ABANDONED

Map No. 10 Sec. 7 Twp. 28 R. 7EWell No. 2 SutterMurfin et al

Company

FIRST REPORT

Contractor

SECTION PLAT

NE/C

330 Ft. from N. Line Ft. from S. Line330 Ft. from E. Line Ft. from W. Line

BEAUMONT POOL

			0

Location Rig up

Drilling and Remarks:

Cable

RECORDCased in., ft.Sand Gas Oil Total Depth **PRODUCTION**1st 24 hrs. Nat. 1st 24 hrs. after shot Gas Cu. Ft.Dry Hole Abandoned

Date

AUG 20 1941 19S. J. LEWIS Scout

Butler

KANSAS

Map No. 10 Sec. 7 Twp. 28 R. 7EWell No. 2 SutterMurfin etal. CompanyABANDONED Contractor

NE/C

330 Ft. from N. Line Ft. from S. Line330 Ft. from E. Line Ft. from W. Line

SECTION PLAT

			0

BEAUMONT POOL

Location Rig up

Drilling and Remarks:

*Miss 2709**Water*

RECORD

Cased in., ft.Sand Gas Oil Total Depth 2721

PRODUCTION

1st 24 hrs. Nat. 1st 24 hrs. after shot Gas Cu. Ft.Dry Hole Abandoned

Date

DEC 17 1941

19

S. J. LEWIS

Scout