


Map No. Kansas Sec. 22 Twp. 28 R. 6

Well No. 1 Pettit Farm _____
Connell oil Company _____

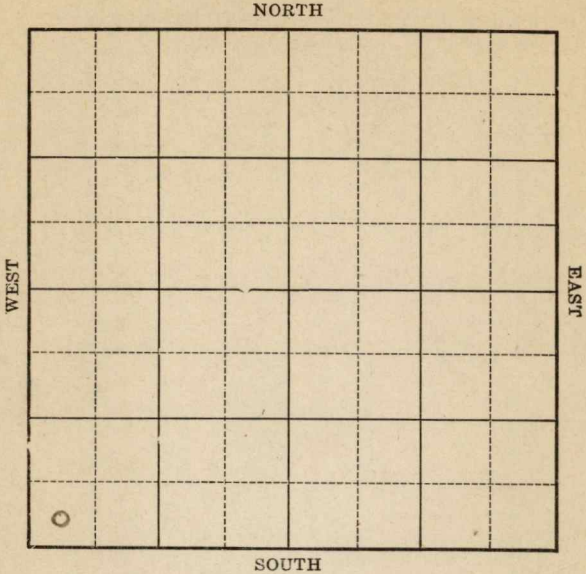

Location _____

Drilling Remarks _____

Rig Up _____

Drilling Remarks _____

RECORD

Cased _____ in. _____ ft.

Sand _____

Gas _____

Oil _____

Total Depth _____

PRODUCTION

1st 24 hrs. Nat. _____


1st 24 hrs. after shot _____

Gas _____ cu. ft.

Dry Hole _____

Abandoned _____

Map No. Kansas Sec. 22 Twp. 28 R. 6
 Well No. 1 Pettit Farm
Cornell Oil Company

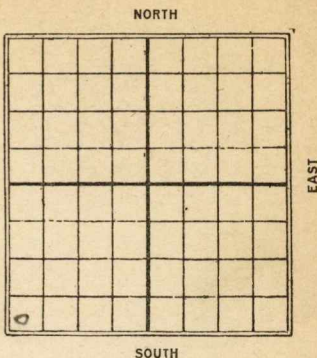

_____ Ft. from N. Line
250 Ft. from S. Line
 _____ Ft. from E. Line
250 Ft. from W. Line

Date	REPORT
1/26	
1/20	Sly 500
1/27	✓ 900
2/1	✓ 1400'
2/10	I.D. 1590' U.R. 10" 1495'
2/17	Drill 1810
2/24	✓ 200 7 Bails uti per hr.
3/5	✓ 2735'
3/10	" 2827
3/18	S.D. 2525'
3/25	Same acreage contract.
4/1	_____
4/7	_____
4/12	Top Line 2845 S.D. 2870 small show oil (see)
4/14	_____
4/21	U.R. 2870
4/22	_____
5/8	S.D. 2870
5/12	Fishing at 2870'
5/19	_____
6/2	Show oil 2895' Drilg. 3000'
6/9	S. & A. 3305

K11 Map No. **KANSAS** Sec. *22* Twp. *28* R. *6*

Well No. *1* *Pettit* Company *Cornell oil Co*

Contractor

FIRST REPORTS

SECTION PLAT

_____ Ft. from N. Line

250

_____ Ft. from S. Line

_____ Ft. from E. Line

250

_____ Ft. from W. Line

Formerly John Sharp.

Location _____

Rig up _____

Drilling and Remarks:

Depth 500'

RECORD

Cased _____ in., _____ ft.

Sand _____

Gas _____

Oil _____

Total Depth _____

PRODUCTION

1st 24 hrs. Nat. _____

1st 24 hrs. after shot _____

Gas _____ Cu. Ft.

Dry Hole _____

Abandoned _____

Date

JAN 20 1926

CHAS. L. SHERWOOD

Butter Co

Map No. K11 KANSAS Sec. 22 Twp. 28 R. 6

Well No. 1 Letting

Cornell Oil Co Company

Contractor

COMPLETED

SECTION PLAT

----- Ft. from N. Line

250

----- Ft. from S. Line

----- Ft. from E. Line

250

----- Ft. from W. Line

ABANDONED

	MID-CONT		
0			

Location -----

Rig up -----

Drilling and Remarks:

Top line 2845
1st break 2870 small
showing oil.
Wilcox 2276-78
DW 3305

RECORD

Cased ----- in., ----- ft.

Sand -----

Gas -----

Oil -----

Total Depth 3305

PRODUCTION

1st 24 hrs. Nat. -----

1st 24 hrs. after shot -----

Gas ----- Cu. Ft.

Dry Hole

Abandoned

Date

JUN 9 1926

192

CHAS. L. SHERWOOD

Scout