


Section 8 Township 14 Range 17W

Well No. 1 A. Lang

Company Amerada Petr.

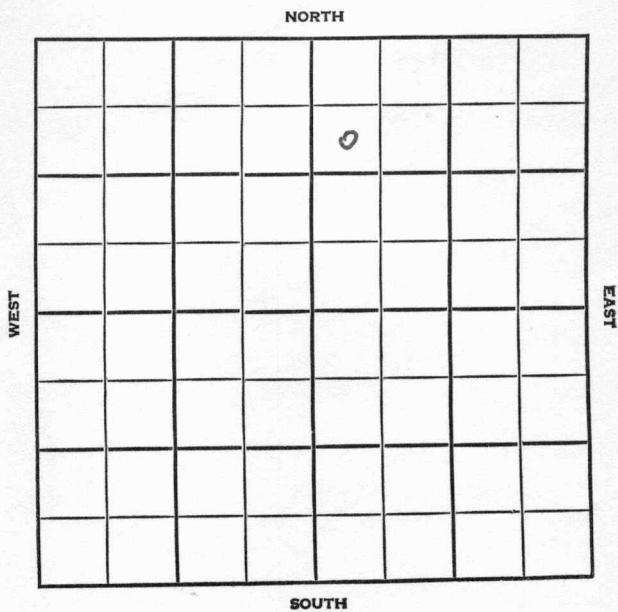


County Ellis State Kansas

Sec. 8 (Blk. Twp.) 14 (Sur. Rge.) 17W Map No.

Operator Amerada Petroleum

Well No. 1 Farm A. Lang

Elev. 2008 Location SW NW NE

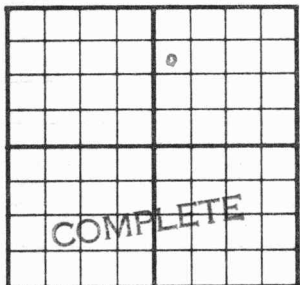

990 Ft. From N Line NE

330 Ft. From W Line Quarter

Ist. Report

Completion FEB 23 1955

Remarks S. Younger Pool

Barbour - Contr.

Spudding Date 1-7-55

Drlg. Data Oil well TD 3556

8" @ 216 Anhy 1200 Heeb. 3259

Tor. 3276 Lans. 3302 Cong. 3537

Arb. 3541 DST 3542-47 open 1 hr.

Rec. 10' socm 90# DST 3528-47

open 1 hr. Rec. 10' mud 90#

DST 3544-56 open 2 hr. Rec. 90' hocm

30' mud 580# TD 3556 5" @ 3547

CO to 3556 350 A S & B/ 20 goph 7 $\frac{1}{2}$ hr.

1000 A S & B/ 26.5 bo 13 hr.

P/ 3 bo 50 bw 12 hr. P/ 30 bo 15 bwpd

Comp. 60 bopd 2.6 bw

FABEN GILSTRAP