


Section 7 Township 28 Range 7-E

Well No. 3 Sutter

Company Rex & Morris

NORTH Keighley Pool

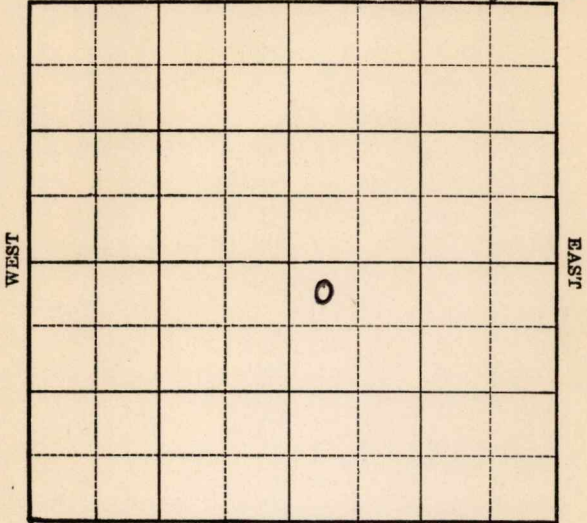

SOUTH

Sec. 7 Twp. 28 R. 7-E

Well No. #3 Sutter Farm

Rex & Morris Company


(Keighley)

330 Ft. from N. Line

\_\_\_\_\_ Ft. from S. Line

\_\_\_\_\_ Ft. from E. Line

330 Ft. from W. Line

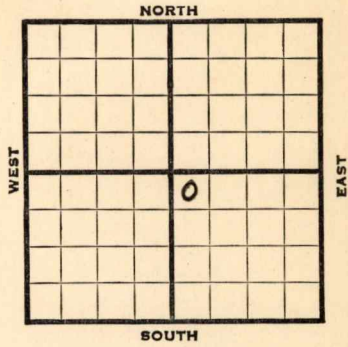

1939	REPORT
4/26	Location
5/5	<del>15'</del> 15' of 20" Drlg. 445'
5/12	12" - 743' Drlg. 1450'
5/19	10" - 1553' Drlg. 2330'
5/26	Bart. 2635' Pay 2635-53' T.D. 6" - 2626' WOC.
5/31	Bart. 2635' Pay 2635-53' 6" - 2626' T.D. 2653' Shot 70 qts. Estimated 30 bbls.
	<b>COMPLETED</b>

Map No. 10 Sec. 7 Twp. 28 R. 7E

Well No. 3 Sutter

Rex & Morris Company

Contractor

FIRST REPORT

NW SE

330 Ft. from N. Line

\_\_\_\_\_ Ft. from S. Line

\_\_\_\_\_ Ft. from E. Line

330 Ft. from W. Line

SECTION PLAT

		0	

KEIGHLEY POOL

Location X

Rig up \_\_\_\_\_

Drilling and Remarks:

RECORD

Cased \_\_\_\_\_ in., \_\_\_\_\_ ft.

Sand \_\_\_\_\_

Gas \_\_\_\_\_

Oil \_\_\_\_\_

Total Depth \_\_\_\_\_

PRODUCTION

1st 24 hrs. Nat. \_\_\_\_\_

1st 24 hrs. after shot \_\_\_\_\_

Gas \_\_\_\_\_ Cu. Ft.

Dry Hole \_\_\_\_\_

Abandoned \_\_\_\_\_

Date

APR 26 1939 19

H. D. Hatfield Scout

Map No. 10 Sec. 7 Twp. 28 R. 7E

Well No. 3 Sutter

Rex & Morris

Company

Contractor

COMPLETED

SECTION PLAT

		0	

NW SE

330 Ft. from N. Line

\_\_\_\_\_ Ft. from S. Line

\_\_\_\_\_ Ft. from E. Line

330 Ft. from W. Line

KEIGHLEY POOL

Location \_\_\_\_\_

Rig up \_\_\_\_\_

Drilling and Remarks:

*Box 2635  
 Pay 2635.53  
 6" @ 2626  
 Box 70 gts.  
 Estimated  
 30 x 14*

RECORD

Cased \_\_\_\_\_ in., \_\_\_\_\_ ft.

Sand \_\_\_\_\_

Gas \_\_\_\_\_

Oil \_\_\_\_\_

Total Depth 2653

PRODUCTION

1st 24 hrs. Nat. \_\_\_\_\_

1st 24 hrs. after shot \_\_\_\_\_

Gas \_\_\_\_\_ Cu. Ft.

Dry Hole \_\_\_\_\_

Abandoned \_\_\_\_\_

Date

MAY 31 1939

19

S. J. LEWIS Scout