

Butler
KANSAS Sec. *25* Twp. *25*^S R. *4*^E
 Well No. *1- Gaines* Farm
Senclair Company

NORTH

			0				

WEST

EAST

SOUTH

Location.....

Drilling Remarks

.....

.....

RECORD

Cased.....in.....ft.
 Sand.....
 Gas.....
 Oil.....
 Total Depth.....

Rig Up.....

Drilling Remarks

.....

.....

PRODUCTION

1st 24 hrs. Nat.....
 1st 24 hrs. after shot.....
 Gas.....cu. ft.....
 Dry Hole.....
 Abandoned.....

Map No. Sec. Twp. R.

Well No. Farm


..... Company

..... Ft. from N. Line

..... Ft. from S. Line

..... Ft. from E. Line

..... Ft. from W. Line

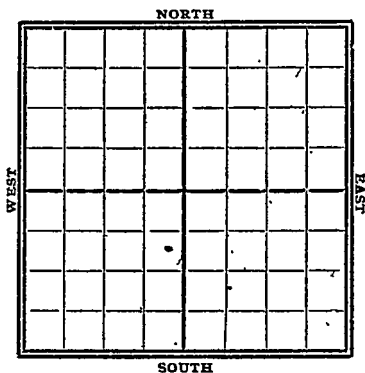

Date

REPORT

1917

Gypsy Records

5/16 *Abd T.D. 2600'*

Butler
 K14 KANSAS SEC. *78* TWP. *78S* R. *4E*

WELL NO. *1 Griner*
Senclair COMPANY

CONTRACTOR

SECTION PLAT

ABANDONED

	e		

_____ FT. FROM N. LINE

_____ FT. FROM S. LINE

_____ FT. FROM E. LINE

_____ FT. FROM W. LINE

RECORD

LOCATION _____

CASED _____ IN. _____ FT.

RIG UP _____

SAND _____

DRILLING AND REMARKS:

GAS _____

OIL _____

TOTAL DEPTH *7600*

PRODUCTION

1ST 24 HRS. NAT. _____

1ST 24 HRS. AFTER SHOT _____

GAS _____ CU. FT.

DRY HOLE *✓*

ABANDONED *✓*

DATE

5-16 19*27* SCOUT