

KANSAS


Ellis County

FORM 51 5M BRIX

Section 6 Township 14 Range 17W

Well No. #1 Younger "B"

Company Sunray Co

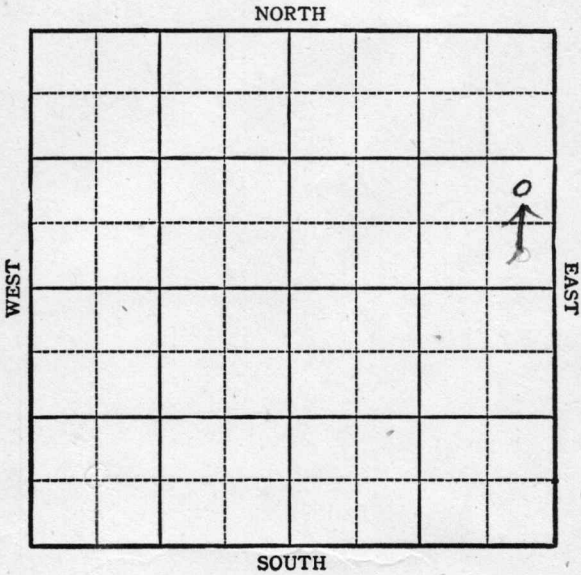

KANSAS

Ellis

Sec. 6 Twp. 14 R. 17W

Well No. #1 Younger "B" Farm

Sunray Company

Wildcat

Ft. from N. Line


990
330

Ft. from S. Line

330

Ft. from E. Line

Ft. from W. Line

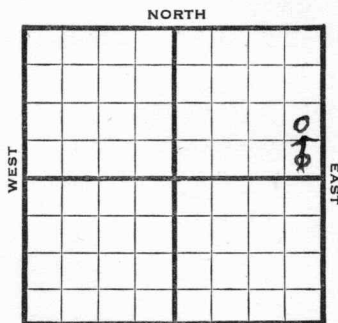

NESE NE

Elw. 2004

SOUTH

1944

REPORT

9/6

Rotary

9/13

10" @ 193

Drlg. 2375

9/21

Topeka 3038

Neebner 3246

Lans 3285

Arb 3523

Drlg. 3538

9/28

5" @ 3538

TD 3562 RUST

10/4

TD 3583 500 acid Pump 3 oil p h

10/11

" " " " " " " " " "

10/18

Arb 3523

5" @ 3538

500 acid

Pump 50 pot.

TD 3583

Grav. 33.8

COMPLETED

*3285-
2004/
1281
35-23
2004/
1519*

KANSAS

Pool Name WildcatMap No. 71 Sec. 6 Twp. 14 R. 17WWell No. 1 Younger "B"Sunray


Company

FIRST REPORT

Contractor

SE NE

SECTION PLAT

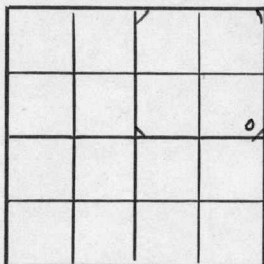

_____ Ft. from N. Line

330 Ft. from S. Line330 Ft. from E. Line

_____ Ft. from W. Line

Ellis County

Location _____

Rig up _____

Drilling and Remarks:

Rotary

RECORD

Cased _____ in., _____ ft.

Sand _____

Gas _____

Oil _____

Total Depth _____

PRODUCTION

1st 24 hrs. Nat. _____

1st 24 hrs. after shot _____

Gas _____ Cu. Ft.

Dry Hole _____

Abandoned _____

Date

SEP 6 1944 19S. J. LEWIS Scout

Pool Name WildcatMap No. 71 Sec. 6 Twp. 14 R. 17WWell No. 1 Younger "B"S unray

Company

CORRECTION

Contractor

NE SE NE**SECTION PLAT**

			o

Ft. from N. Line990 Ft. from S. Line330 Ft. from E. LineFt. from W. LineEllis County

Location _____

Rig up _____

Drilling and Remarks:

Reported

SE NE**RECORD**

Cased _____ in., _____ ft.

Sand _____

Gas _____

Oil _____

Total Depth _____

PRODUCTION

1st 24 hrs. Nat. _____

1st 24 hrs. after shot _____

Gas _____ Cu. Ft.

Dry Hole _____

Abandoned _____

Date

SEP 20 194419S. J. LEWIS

Scout

Pool Name WildcatMap No. 71 **KANSAS** Sec. 6 Twp. 14 R. 17WWell No. 1 Younger "B"Sunray


Company

COMPLETED

Contractor

NE SE NE

SECTION PLAT

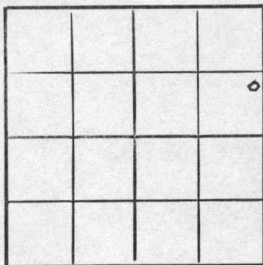Ft. from N. Line990 Ft. from S. Line330 Ft. from E. LineFt. from W. LineEllis County

RECORD

Location _____

Cased _____ in., _____ ft.

Rig up _____

Sand _____

Drilling and Remarks:

Gas _____

Oil _____

Total Depth 2583

PRODUCTION

1st 24 hrs. Nat. _____

1st 24 hrs. after shot _____

Gas _____ Cu. Ft.

Dry Hole _____

Abandoned _____

Date

OCT 1 8 1944

19

S. J. LEWIS

Scout