

Map No. Sec. Twp. R.

Well No. Farm


..... Company

..... Ft. from N. Line

..... Ft. from S. Line

..... Ft. from E. Line

..... Ft. from W. Line

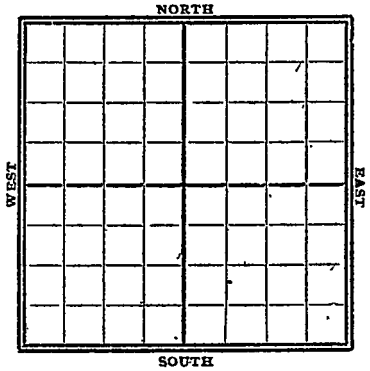

1916

Date

REPORT

Gypsy Records

5/2

Abd T.D 725'

Butler

K14
 MAP NO. KANSAS SEC. 25 TWP. 25S R. 4E

WELL NO. Allen

Bradford Incorporated COMPANY

CONTRACTOR

SECTION PLAT

ABANDONED

_____ FT. FROM N. LINE
 _____ FT. FROM S. LINE
 _____ FT. FROM E. LINE
 _____ FT. FROM W. LINE

	0		

LOCATION _____

RIG UP _____

DRILLING AND REMARKS:



RECORD

CASED _____ IN. _____ FT.
 SAND _____
 GAS _____
 OIL _____
 TOTAL DEPTH 725

PRODUCTION

1ST 24 HRS. NAT. _____
 1ST 24 HRS. AFTER SHOT _____
 GAS _____ CU. FT.
 DRY HOLE ✓
 ABANDONED _____

DATE

5-2 1926

SCOUT