


Section 8 Township 14 Range 17 W

Well No. # 1 Lang

Company Transit Corp & Davis Bros.

NORTH

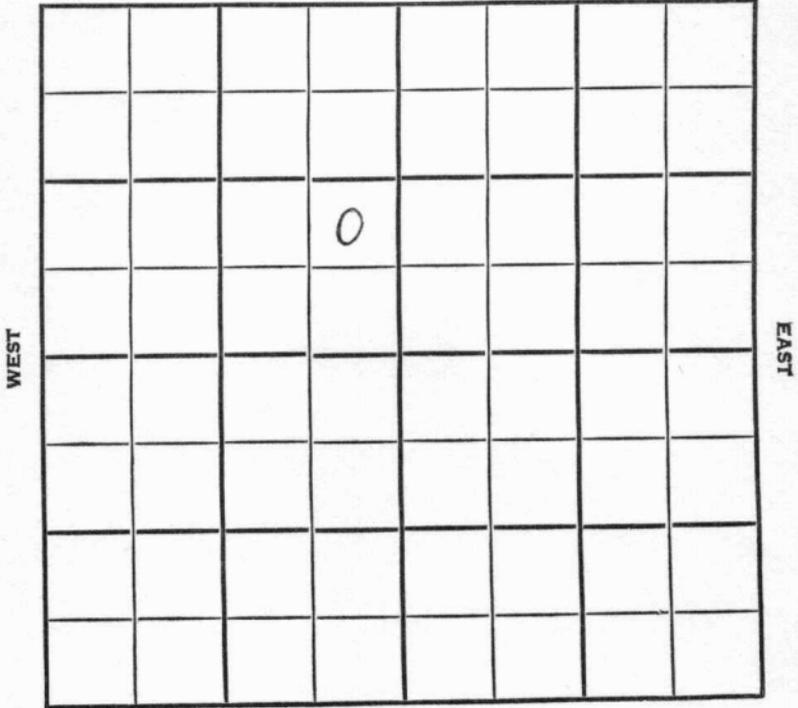

SOUTH

Ellis

KANSAS

SEC.	TWP.	R.
8	14	17 W

WELL NO. # 1 Lang FARM

COMPANY Transit Corp & Davis Bros.

CONTRACTOR Co. Tools

Wildcat


_____ Ft. from N. Line

990 _____ Ft. from S. Line

330 _____ Ft. from E. Line

_____ Ft. from W. Line

NE SE NW

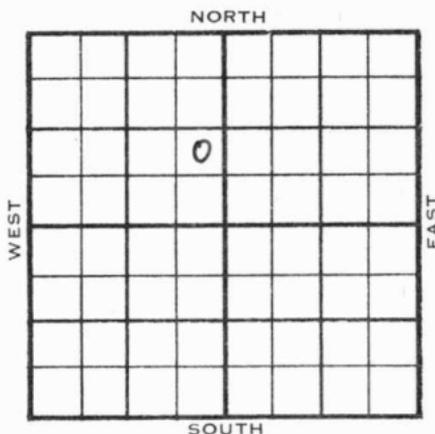

Amerada DHM

1954	ELEVATION	REPORT
	1999'	

9/22

Spud 9-15-54
8" @ 158 Anhy 1215'

Dr1g. 3158'

10/20

Spud 9-15-54 - Oil Well

TD 3553'

8" @ 158'

Anhy 1215', Heeb 3264', Lans 3307',

Tor 3281', Cong. 3541', Arb. 3546'

DST 3547-53', opn 1 hr., rec. 135'

VHOCM, 960#

TD 3553'

5" @ 3547'

CO to 3553'

2/1 boph 500A, S/4 boph 11 hrs.

Comp. 125 bopd

COMPLETED

