


Section 8 Township 14 Range 17 W

Well No. # 2 Lang T.

Company Transit Corp

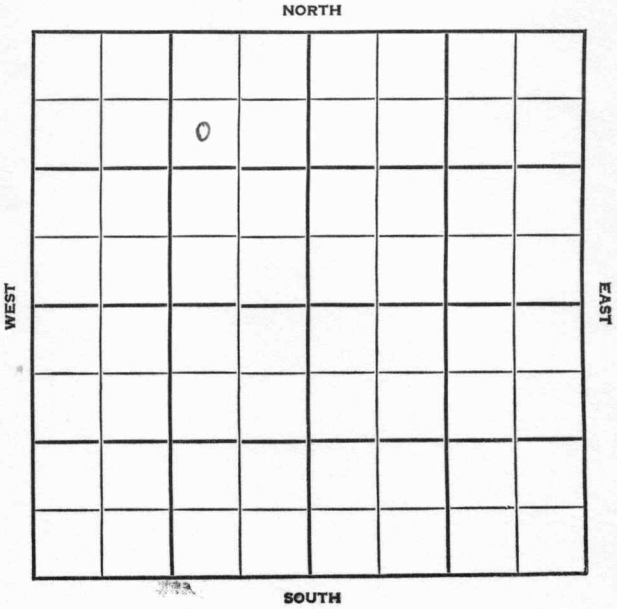

Ellis KANSAS

SEC.	TWP.	R.
8	14	17W

WELL NO. 2 Lang T. FARM

COMPANY Transit Corp.

CONTRACTOR Transit

S. Younger Pool


990 Ft. from N. Line

Ft. from S. Line

990 Ft. from E. Line

Ft. from W. Line

SW NE NW

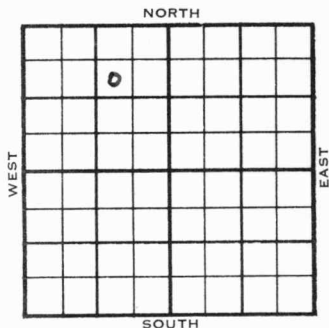

	ELEVATION	REPORT
1954	2007'	

12/1 Spud 11-17-54  
 8" @ 201'  
 Lans 3299', Arb. 3537'  
 DST 3337-54', opn 1 hr., rec. 4' mud  
 Off  
 TD 3544'  
 5" @ 3539'

1955  
 1/5 Spud 11-17-54  
 Oil Well  
 TD 3551'  
 8" @ 201'  
 Lans 3299' Arb. 3537'  
 DST 3337'-54' opn 1 hr, rec 4' Mud  
 Off  
 TD 3544'  
 5" @ 3539' CO to 3544'  
 FU 150' OCM, B/ 20 goph 6 hr. 300 A  
 DD 3551'  
 PB 3540'  
 B/ 20 goph 1000 A  
 Comp 79 bopd. 35% Wtr.

COMPLETED



County Ellis State Kansas

Sec. 8 (<sup>Blk.</sup>14) (<sup>Sur.</sup>17W) Map No.

Operator Transit Corp.

Well No. 2 Farm Lang. T.

Elev. 2007 Location SW NE NW


990 Ft. From N Line NW

990 Ft. From E Line Quarter

1st. Report

Completion JAN 5 1955

Remarks S. Younger Pool

Transit - Contr.

Spudding Date 11-17-54

Drlg. Data Oil well TD 3551

8" @ 201 Lans. 3299 Arb. 3537

DST 3337-54 open 1 hr. Rec. 4' mud

O# TD 3544 5" @ 3539 CO to 3544

FU 150' ocm B/ 20 goph 6 hr. 300A

DD 3551 PB 3540 B/ 20 goph 1000 A

Comp. 79 bopd 35% wtr.

FARM OIL STRAP