


Section 8 Township 14 Range 17W

Well No. 1 Miller

Company K & E Drlg

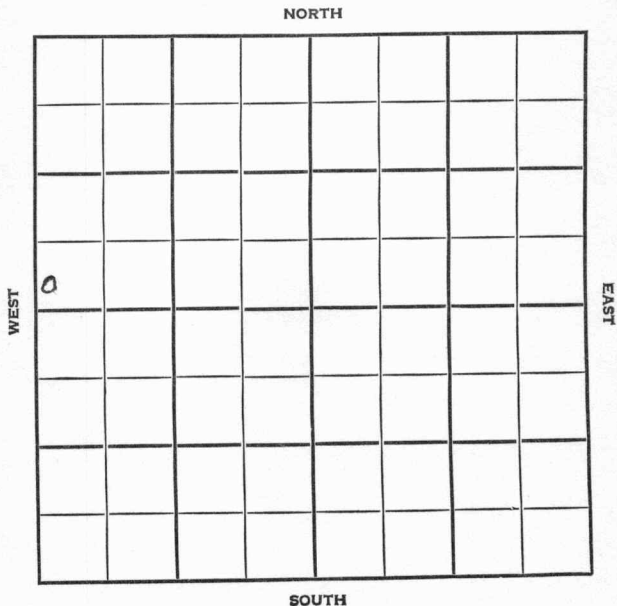

Ellis

KANSAS

SEC. 8	TWP. 14S	R. 17W
-----------	-------------	-----------

WELL NO. \_\_\_\_\_  
 #1 K & E Drlg FARM  
 COMPANY \_\_\_\_\_

Miller  
 CONTRACTOR  
 K & E

Toulon


\_\_\_\_\_ Ft. from N. Line

\_\_\_\_\_ Ft. from S. Line

\_\_\_\_\_ Ft. from E. Line

\_\_\_\_\_ Ft. from W. Line

SW SW NW

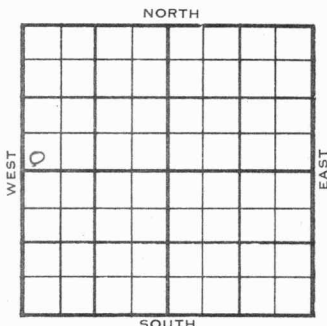

FIRST REPORT

1955	ELEVATION		REPORT
	1955	1999	

7/13 Comm: 7/10/55  
 8" @ 198 w/140 D 2215

7/20 ~~AN~~ Comm 7-10-55  
 Anh 1215  
 Tp 2997  
 H 3272  
 Tr 3290  
 L 3315  
 BKC 3541  
 C ~~34~~ 3560  
 TD 3594  
 8" @ 198/140  
 D & A

ABANDONED

County Ellis Elev. \_\_\_\_\_  
 Sec. 8 Twp. 14S Rge. 17W  
 Company K & E Drlg  
 FarmName Miller No. 1

TOPS	DEPTH	LOG	DATUM
Anh.	1215		
TP.			
H.			
Tr.			
Dg.			
BL.			
L.			
K.C.			
B.K.C.			
Ce.			
C.			
M.			
M.			
K.			
Mz.			
Mq.			
V.			
S.			
S.			
A			
R.			
PE.			
G.			
T.D.			

Loc. in Sec. \_\_\_\_\_

SW SW NW

Geol. \_\_\_\_\_

Contr. \_\_\_\_\_

K & E

Pool \_\_\_\_\_

Toulon


JUL 13 '55

FIRST REPORT

Date Comm. spd 7/10/55, 8" 198 w/140 D2215

~~14~~

Co.

Lse.

No.

Sec.

T.

R.

County Ellis Elev. 1999  
 Sec. 8 Twp. 14 Rge. 17W  
 Company K & E Drilg.  
 FarmName Miller No. 1

TOPS	DEPTH	LOG	DATUM	Loc. in Sec.
Anh.	1215			SW SW NW
TP.	2997		998	
H.	3272		1273	
Tr.	3290		1291	
Dg.				
BL.				
L.	3315		1316	Geol.
K.C.				
B.K.C.	3541		1542	Contr.
Ce.				
C.	3560		1561	K & E
M.				
M.				Pool
K.				Toulon
Mz.				
Mq.				
V.				
S.				
S.				
A				
R.				
PE.				
G.				
TD.	3594			



Date Comm. 7-10-55 JUL 20 1955  
8" @ 198/140

D & A

Co.  
Lse.  
No.  
Sec.  
T.  
R.