


Section 9 Township 14 Range 17W

Well No. #1 Goetz "A"

Company Birmingham-Bartlett Drlg.

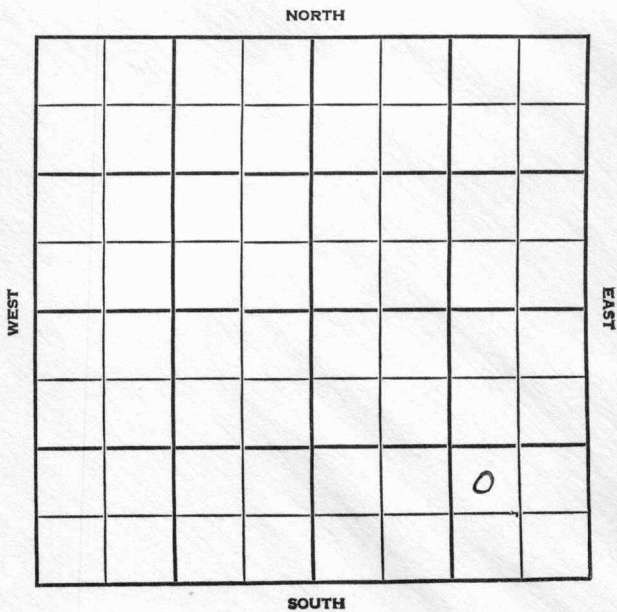

# WILDCAT


FORM 513 SUNRAY

County Ellis Elev. \_\_\_\_\_  
 Sec. 9 Twp. 24 Rge. 17W  
 Company Birmingham-Bartlett Drlg.  
 Farm Name Goetz "A" No. 1

TOPS	DEPTH	LOG	DATUM	Loc. in Sec.
Anh.				NW SE SE
TP.				
H.				
Tr.				
Dg.				
BL.				
L.				Geol. _____
K.C.				Contr. _____
B.K.C.				Co. Tools _____
Ce.				Pool _____
C.				Wildcat
M.				<div style="border: 1px solid black; padding: 5px; text-align: center;"> <p><b>FIRST REPORT</b></p> <p>OCT 24 '56</p> <p><i>1/2 mile</i></p> </div>
M.				
K.				
Mz.				
Me.				
V.				
S.				
S.				
A.				
R.				
PE.				
G.				
T.D.				

Date Comm. Carter FO Davis AC  
 Location \_\_\_\_\_

NOV 5 1956

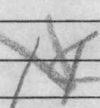

R.G.

Co.  
Lse.  
No.  
Sec.  
T.  
R.

County Ellis Elev. 2014  
 No. 9 Twp. 14 Rgs. 17W  
 Birmingham-Bartlett Drlg.  
 Name Goetz "A" No. 1

TOPS	DEPTH	LOG	DATUM	Loc. in Sec.
Anb.	1180			NW SE SE
Tr.				
H.	3242			
Tr.	3261			
Dg.				
Bl.				
L.	3288			Geol.
K.C.				Contr.
B.K.C.				Co. Tools
Ce.				Toulan s.w
C.				Pool
M.				Wildcat
M.				
K.				
Mz.				
Mo.				
V.				
S.				
S.				DEC 13 '56
A	3528 (GSO)			
R.				
Pe.				
G.				
T.D.	3532			

Date Comm. Carter FO Davis AC  
 Location OCT 31 '56 10-24+50 858  
181165 1D 2985 1D 3183 NOV 7 '56  
DST 3274-3302 1hr 35' MW  
BHP 820 DST 3314-21 op 1hr  
90' SW BHP 800 DST 3326-40  
op 1hr 30' 50CM BHP 0 DST  
3349-62 1hr 170' SW 1000/20"  
DST 3372-99 op 1hr 35' 50CM  
BHP 0 5 1/2 3530/125 NOV 13 '56

CO 3532 no test DD 3543 no test

A channelled. <sup>Radio</sup> active FU 900' Fluid

48 hrs DD 3546 hole saved in

to sq O.H. <sup>NOV 21 '56</sup> sqd O.H. CO DD3548  $\Delta$  \$ 3<sup>3</sup>/<sub>4</sub> Bopd nolw

6 hrs FU 600' oil nolw 6 hrs

\$ 30 Bopd to POP <sup>NOV 28 '56</sup> <sup>DEC 5 '56</sup>

P. 24 Bopd + 25% wtr.

<sup>DEC 12 '56</sup> P. 16 Bopd + 25% wtr.